


**ATTACHMENT I2  
APPENDIX E**


**DESIGN DRAWINGS**

**SHAFT SEALING SYSTEM  
COMPLIANCE SUBMITTAL DESIGN REPORT**

(This page intentionally blank)

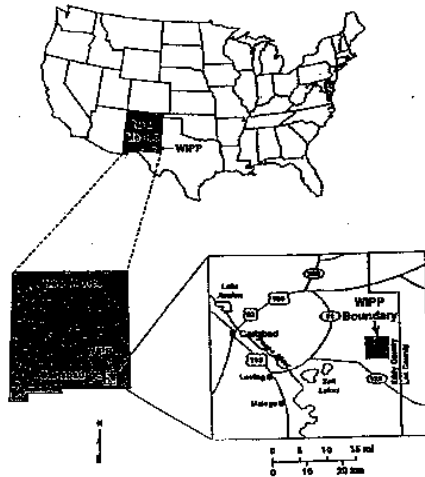

WIPP LAYOUT

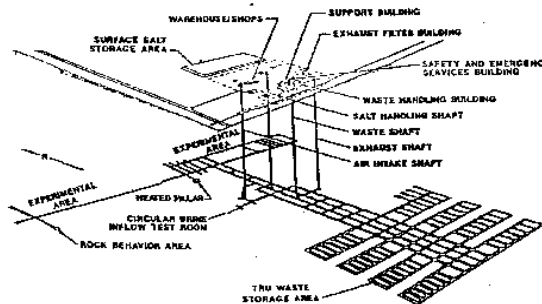


## WASTE ISOLATION PILOT PLANT

CARLSBAD, NM

## SHAFT SEALING SYSTEM DESIGN

### DESIGN DRAWINGS



DRAWING NUMBER	TITLE	DRAWING NUMBER	TITLE	DRAWING NUMBER	TITLE
SNL-007 1 OF 28	WIPP SHAFT SEALING SYSTEM SHAFT LOCATION PLAN, ABBREVIATIONS, GENERAL NOTES AND LEGEND	SNL-007 10 OF 28	WIPP SHAFT SEALING SYSTEM SALADO FORMATION AIR INTAKE SHAFT STRATIGRAPHY & SEALING SUBSYSTEM PROFILE	SNL-007 19 OF 28	WIPP SHAFT SEALING SYSTEM NEAR-SURFACE/RUSTLER FORMATIONS SALT HANDLING SHAFT STRATIGRAPHY & SEALING SUBSYSTEM PROFILE
SNL-007 2 OF 28	WIPP SHAFT SEALING SYSTEM NEAR-SURFACE/RUSTLER FORMATIONS WASTE SHAFT STRATIGRAPHY & AS-BUILT ELEMENTS	SNL-007 13 OF 28	WIPP SHAFT SEALING SYSTEM AIR INTAKE SHAFT SHAFT STATION MONOLITH	SNL-007 20 OF 28	WIPP SHAFT SEALING SYSTEM SALADO FORMATION SALT HANDLING SHAFT STRATIGRAPHY & SEALING SUBSYSTEM PROFILE
SNL-007 3 OF 28	WIPP SHAFT SEALING SYSTEM SALADO FORMATION WASTE SHAFT STRATIGRAPHY & AS-BUILT ELEMENTS	SNL-007 12 OF 28	WIPP SHAFT SEALING SYSTEM NEAR-SURFACE/RUSTLER FORMATIONS EXHAUST SHAFT STRATIGRAPHY & AS-BUILT ELEMENTS	SNL-007 21 OF 28	WIPP SHAFT SEALING SYSTEM SALT HANDLING SHAFT SHAFT STATION MONOLITH
SNL-007 4 OF 28	WIPP SHAFT SEALING SYSTEM NEAR-SURFACE/RUSTLER FORMATIONS WASTE SHAFT STRATIGRAPHY & SEALING SUBSYSTEM PROFILE	SNL-007 13 OF 28	WIPP SHAFT SEALING SYSTEM SALADO FORMATION EXHAUST SHAFT STRATIGRAPHY & AS-BUILT ELEMENTS	SNL-007 24 OF 28	WIPP SHAFT SEALING SYSTEM CONCRETE-ASPHALT WATERSTOP IN SALADO FORMATION
SNL-007 5 OF 28	WIPP SHAFT SEALING SYSTEM SALADO FORMATION WASTE SHAFT STRATIGRAPHY & SEALING SUBSYSTEM PROFILE	SNL-007 14 OF 28	WIPP SHAFT SEALING SYSTEM NEAR-SURFACE/RUSTLER FORMATIONS EXHAUST SHAFT STRATIGRAPHY & SEALING SUBSYSTEM PROFILE	SNL-007 24 OF 28	WIPP SHAFT SEALING SYSTEM UPPER AND LOWER SALADO COMPACTED CLAY COLUMNS
SNL-007 6 OF 28	WIPP SHAFT SEALING SYSTEM WASTE SHAFT SHAFT STATION MONOLITH	SNL-007 15 OF 28	WIPP SHAFT SEALING SYSTEM SALADO FORMATION EXHAUST SHAFT STRATIGRAPHY & SEALING SUBSYSTEM PROFILE	SNL-007 25 OF 28	WIPP SHAFT SEALING SYSTEM COMPACTED SALT COLUMN
SNL-007 7 OF 28	WIPP SHAFT SEALING SYSTEM NEAR-SURFACE/RUSTLER FORMATIONS AIR INTAKE SHAFT STRATIGRAPHY & AS-BUILT ELEMENTS	SNL-007 16 OF 28	WIPP SHAFT SEALING SYSTEM EXHAUST SHAFT SHAFT STATION MONOLITH	SNL-007 26 OF 28	WIPP SHAFT SEALING SYSTEM CONCRETE FILL
SNL-007 8 OF 28	WIPP SHAFT SEALING SYSTEM SALADO FORMATION AIR INTAKE SHAFT STRATIGRAPHY & AS-BUILT ELEMENTS	SNL-007 17 OF 28	WIPP SHAFT SEALING SYSTEM NEAR-SURFACE/RUSTLER FORMATIONS SALT HANDLING SHAFT STRATIGRAPHY & AS-BUILT ELEMENTS	SNL-007 27 OF 28	WIPP SHAFT SEALING SYSTEM RUSTLER COMPACTED CLAY COLUMN
SNL-007 9 OF 28	WIPP SHAFT SEALING SYSTEM NEAR-SURFACE/RUSTLER FORMATIONS AIR INTAKE SHAFT STRATIGRAPHY & SEALING SUBSYSTEM PROFILE	SNL-007 28 OF 28	WIPP SHAFT SEALING SYSTEM SALADO FORMATION SALT HANDLING SHAFT STRATIGRAPHY & AS-BUILT ELEMENTS	SNL-007 28 OF 28	WIPP SHAFT SEALING SYSTEM COMPACTED EARTH FILL AND CONCRETE FILL

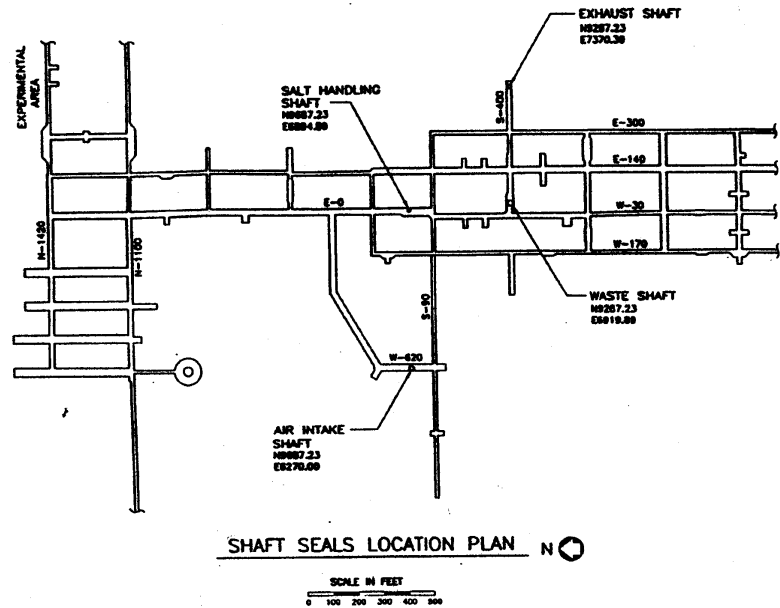

#### GENERAL NOTES:

1. THE SHFT NUMBERING SYSTEM (E-300, S-400, ETC.) IS BASED ON THE DIRECTION AND NOMINAL DISTANCE IN FEET THE SHFT IS FROM THE SALT HANDLING SHAFT'S DESIGNATED CENTERLINE LOCATION OF N-000, E-000. THE WPP PLANT COORDINATE SYSTEM CENTERLINE LOCATION FOR THE SALT HANDLING SHAFT IS N8887.23, AND E8884.89. THE PLANT COORDINATE SYSTEM IS DESCRIBED IN WESTINGHOUSE DRAWING NO. 51-W-100-W, UNDERGROUND EXCAVATIONS, DATED 8/15/92.
2. THE AS-BUILT DIMENSIONS AND DEPTHS AND/OR ELEVATIONS SHOWN IN THESE DRAWINGS ARE NOMINAL. IN THIS DIMENSIONS MAY CHANGE DUE TO LOCAL VARIANCE OF THE ENVIRONMENTAL CONDITIONS. MODIFICATIONS MADE TO SATISFY THE CRISP CLOSURE OF THE SHAFT, AND OTHER OPERATIONAL REQUIREMENTS. THEREFORE THE AS-BUILT DIMENSIONS AND THE PERTINENT ELEVATIONS FOR THE SEALING SYSTEM SHALL BE VERIFIED BY FIELD SURVEYS AND EXPLORATORY CORE DRILLING DURING SITE PREPARATION FOR THE FINAL CONSTRUCTION.
3. **DRAWING NUMBERS.**  
FOR CLARITY ON DETAIL AND SECTION DESIGNATIONS, AND NOTES, ONLY THE SHEET NUMBER IS SHOWN.

#### LEGEND FOR PROPOSED SHAFT SEALING SYSTEM:

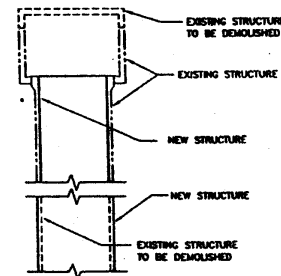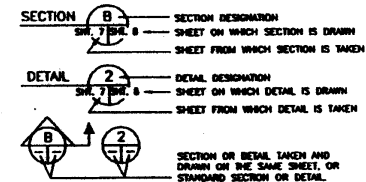


#### ABBREVIATIONS:


E	CENTERLINE
ANL	ANNOUITE
CMP	CORRUGATED METAL PLATE
CONC.	CONCRETE
DOE	DEPARTMENT OF ENERGY
DWG.	DRAWING
E	EAST
EL.	ELEVATION
EXIST.	EXISTING
FT.	FOOT, FEET
HT.	HEIGHT
I.D.	INSIDE DIAMETER
IN.	INCHES
MB	MARKER BED
MBL	MINIMUM
MSL	MEAN SEA LEVEL
N	NORTH
NO.	NUMBER
R	RADIUS
S	SOUTH
SHT.	SHEET NUMBER
SMC	SALADO MASS CONCRETE
TYP.	TYPICAL
USGS	UNITED STATES GEOLOGICAL SURVEY
W	WEST
WID	WESTINGHOUSE WASTE ISOLATION DIVISION
WPP	WASTE ISOLATION PILOT PLANT





*Albert W. Dennis*  
9-2-96

REV.	DATE	DESCRIPTION	BY	CL.	APP.
1	8/2/96	ISSUED FOR RECORD PACKAGE			
<b>SANDIA NATIONAL LABORATORIES</b> <b>WIPP A/E SUPPORT</b> <b>WPP SHAFT SEALING SYSTEM</b> <b>SHAFT LOCATION PLAN,</b> <b>ABBREVIATIONS, GENERAL</b> <b>NOTES AND LEGEND</b>					
PREPARED BY: SANDIA NATIONAL LABORATORIES CHECKED BY: SANDIA NATIONAL LABORATORIES DATE: 8/2/96		SCALE: 1" = 100' SHEET NO.: 1 OF 28			

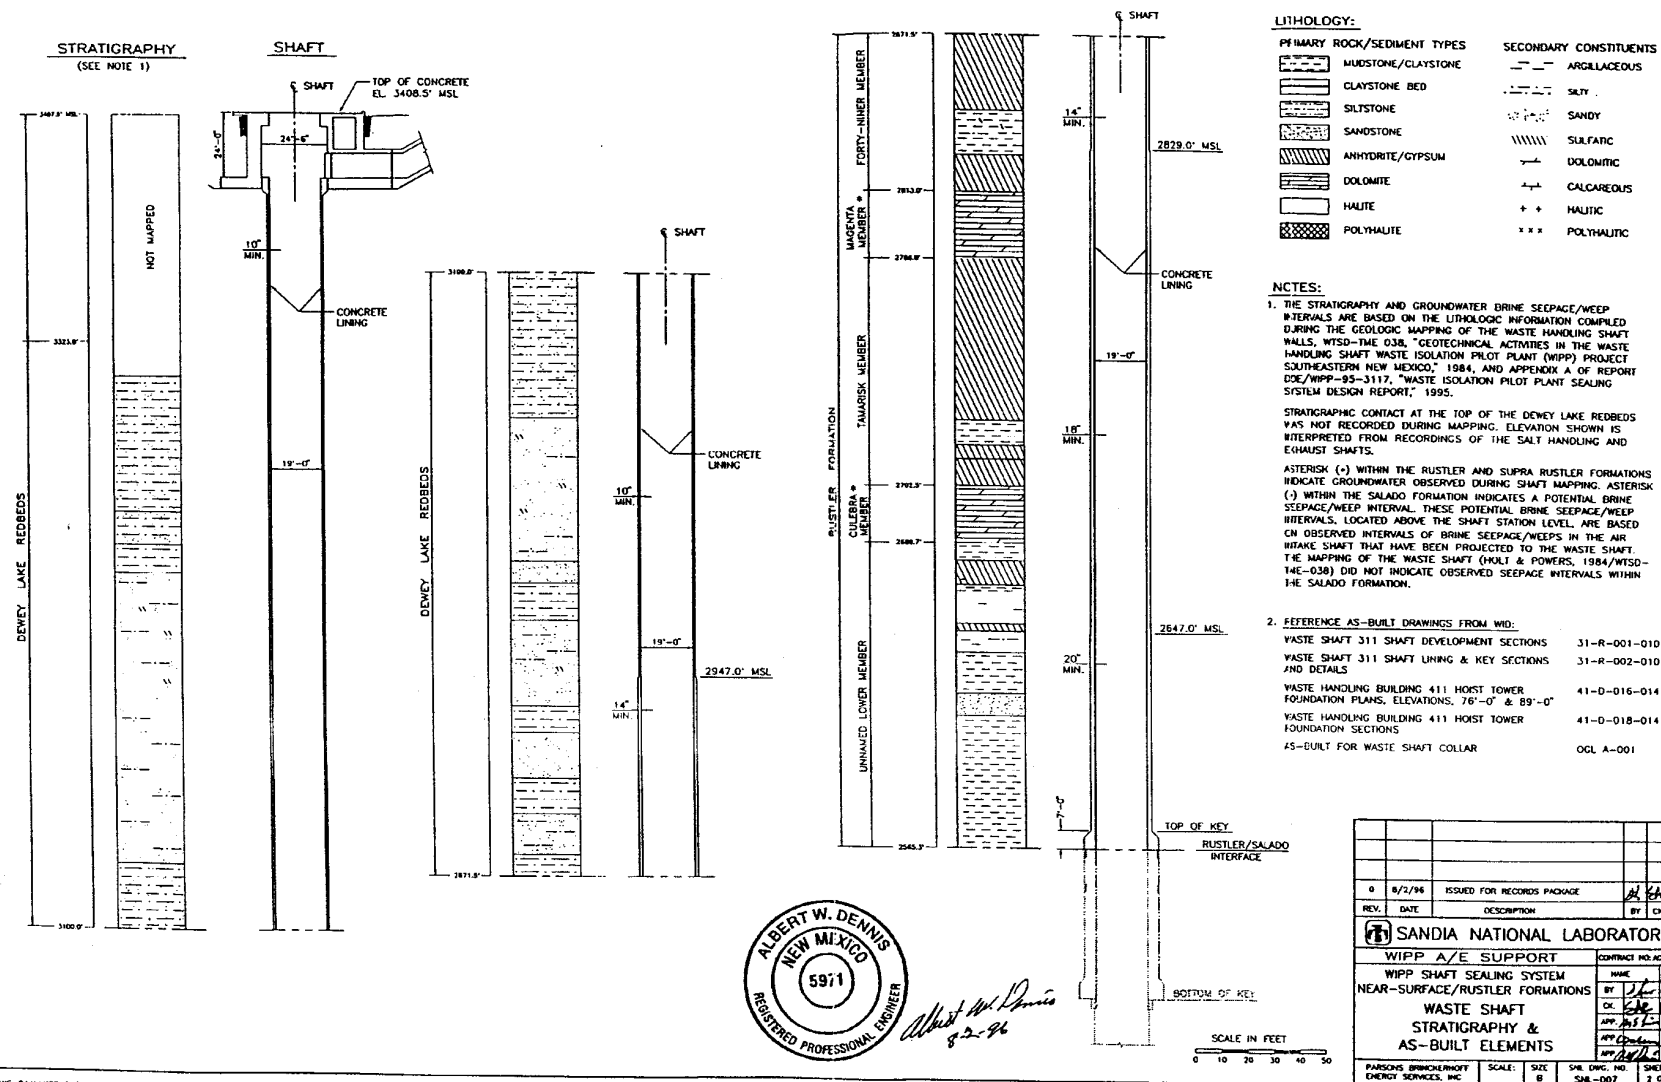


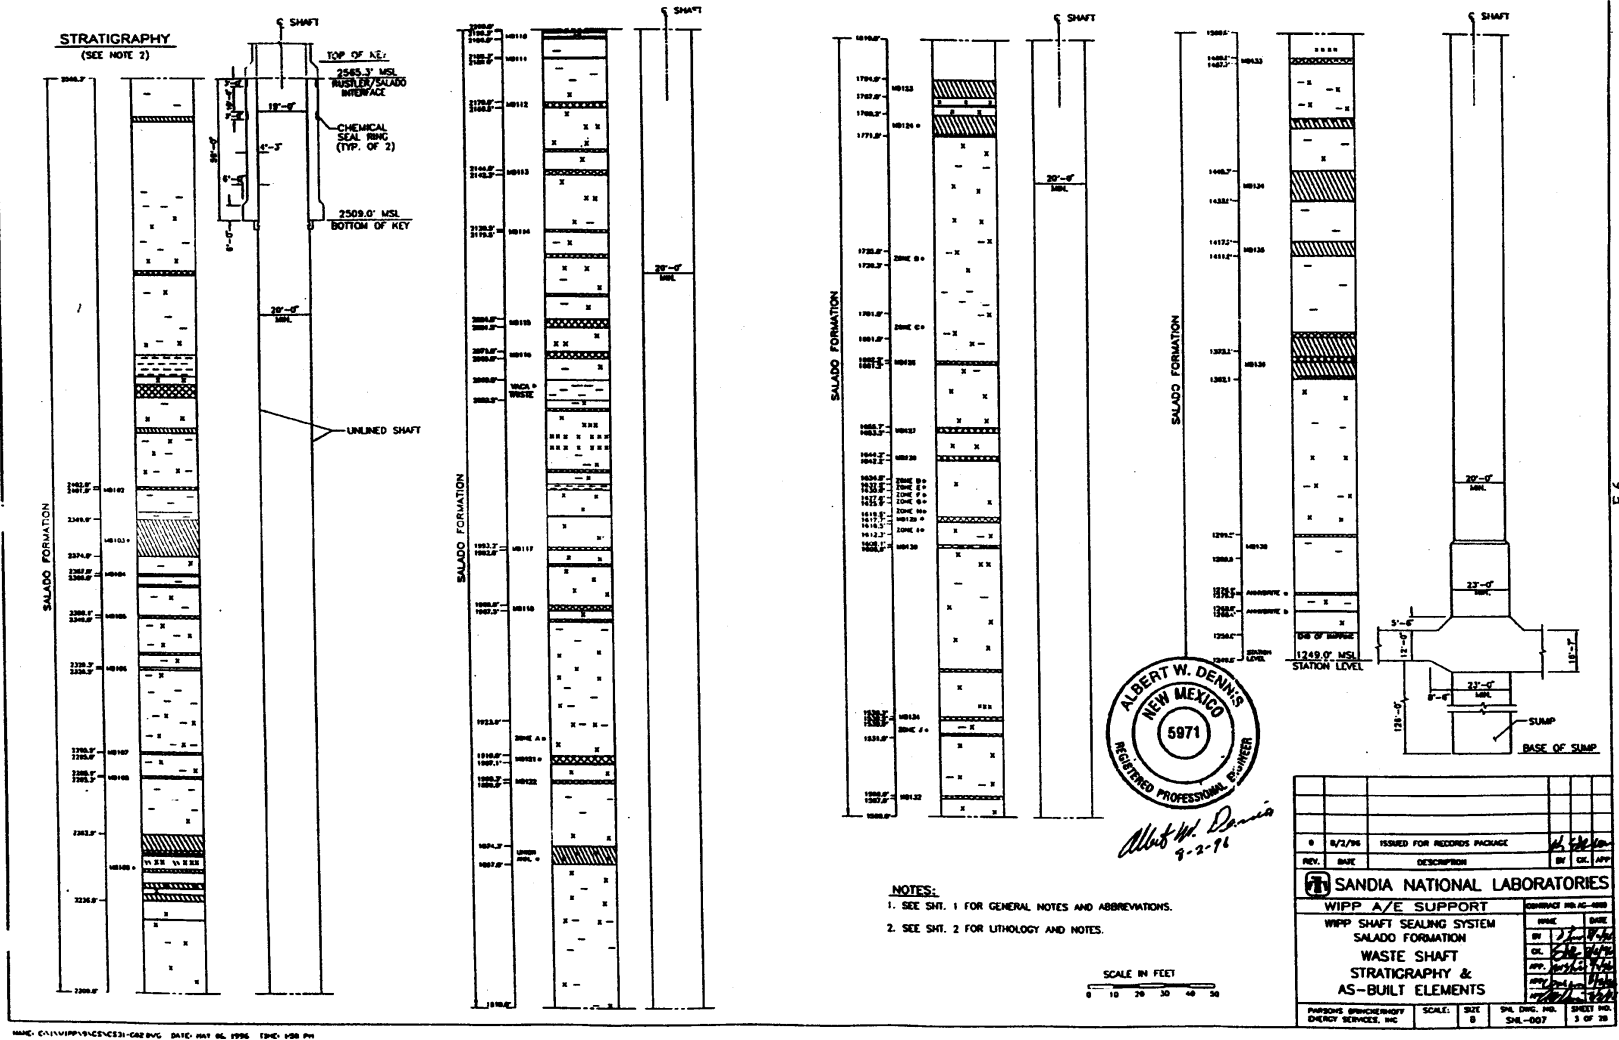


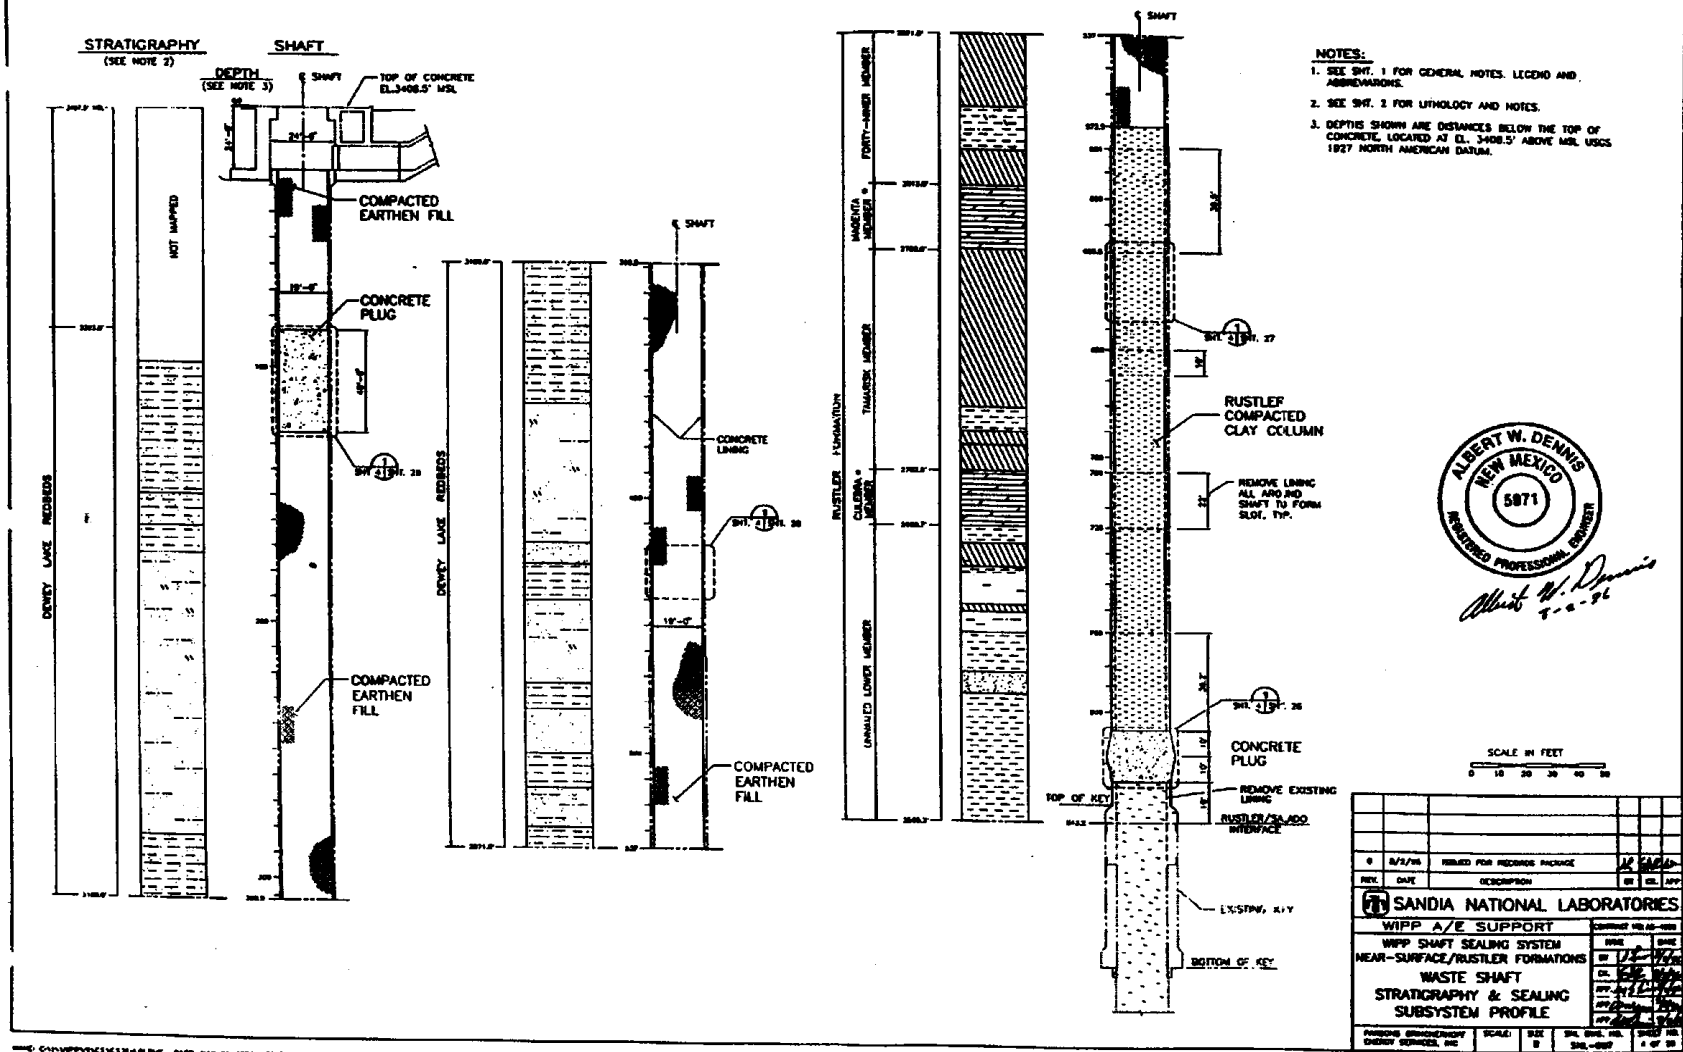


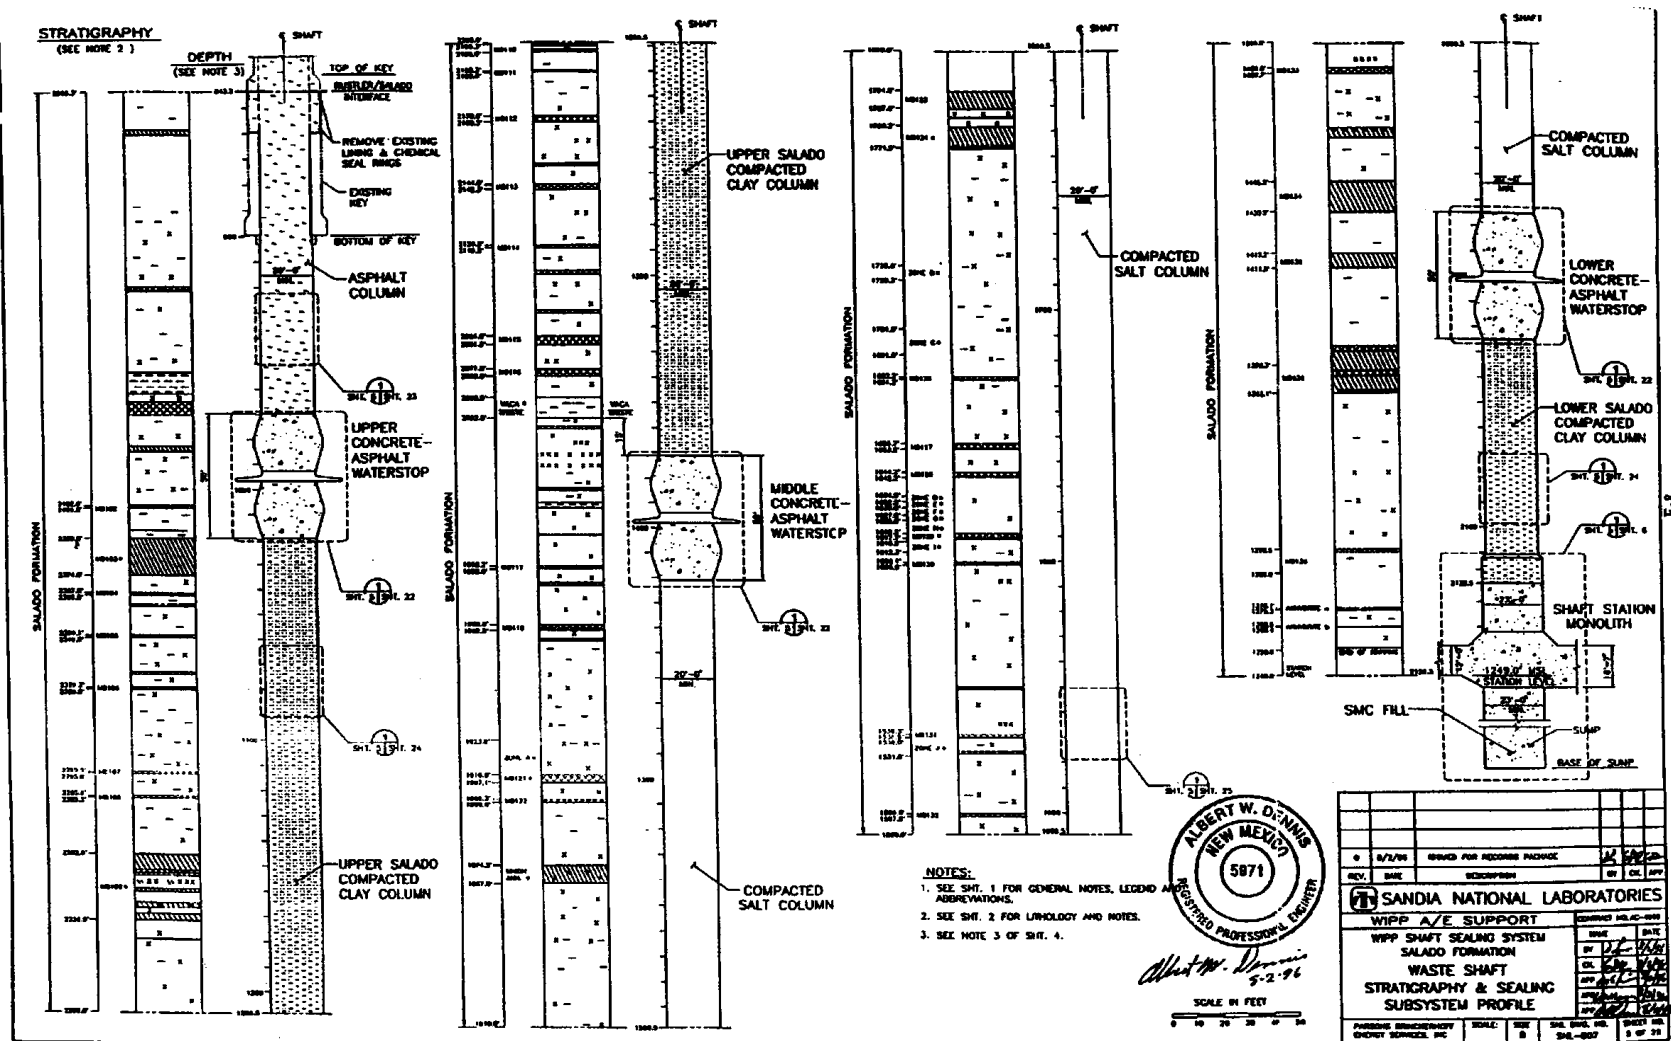






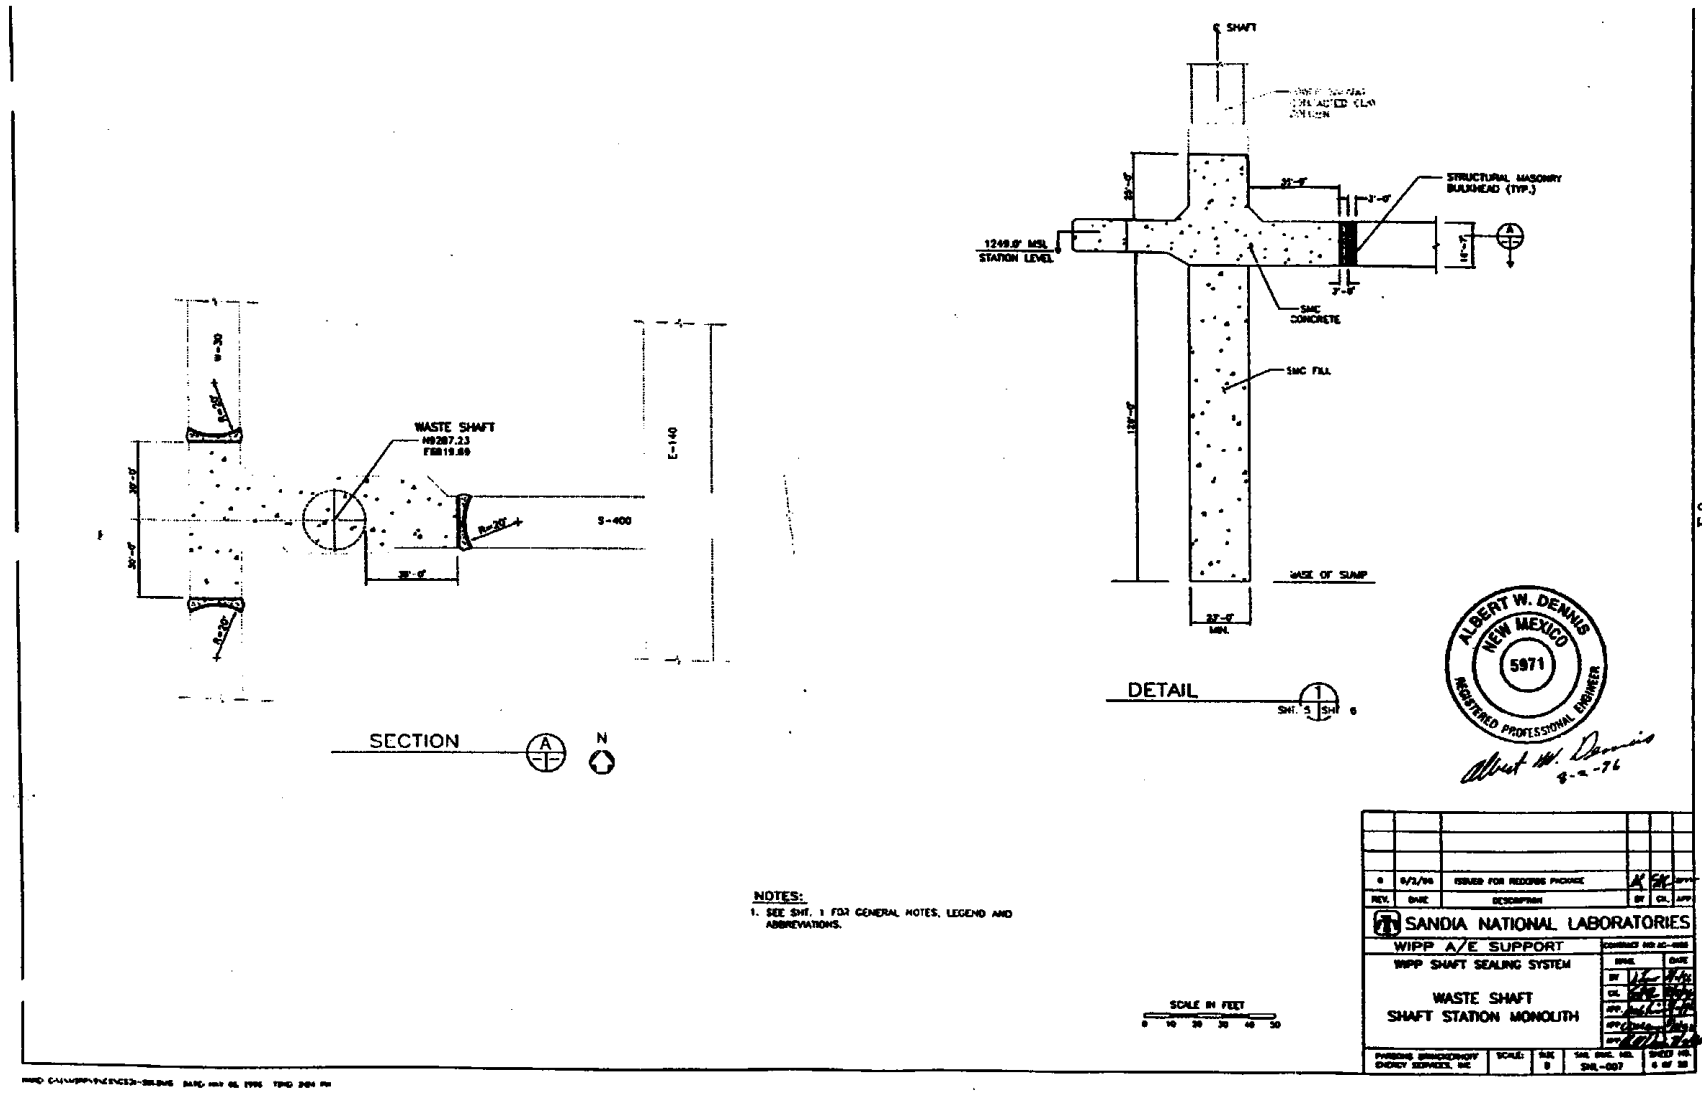


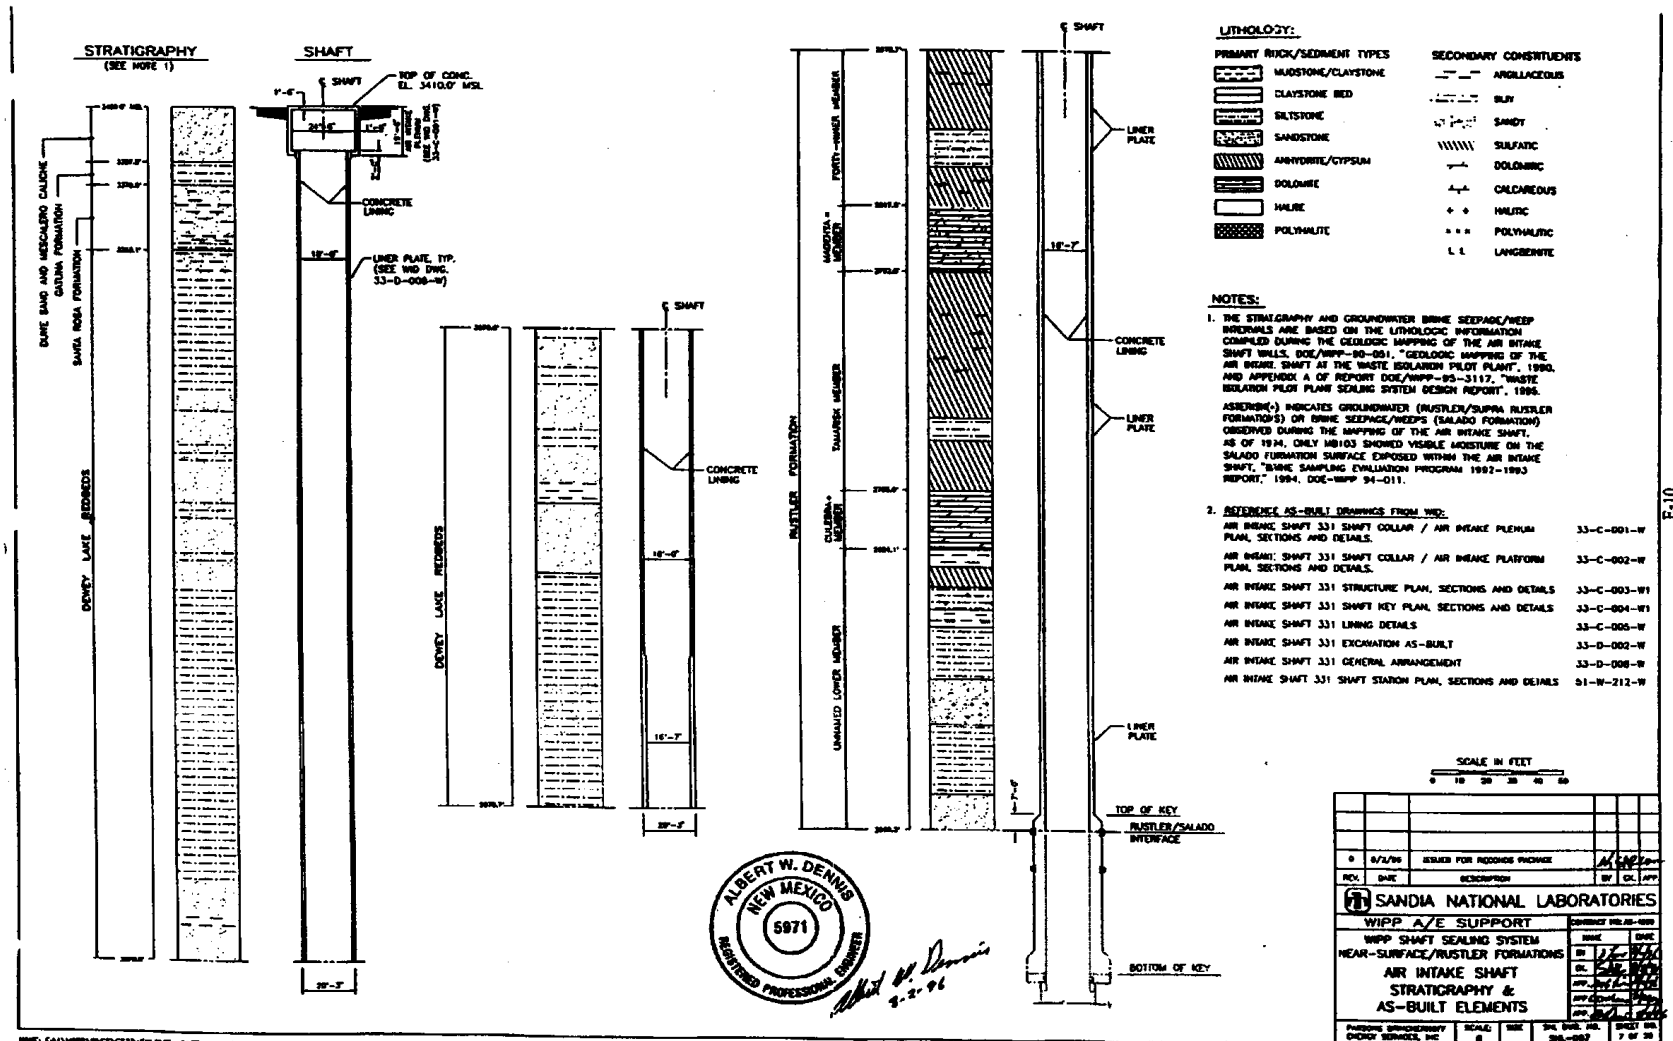

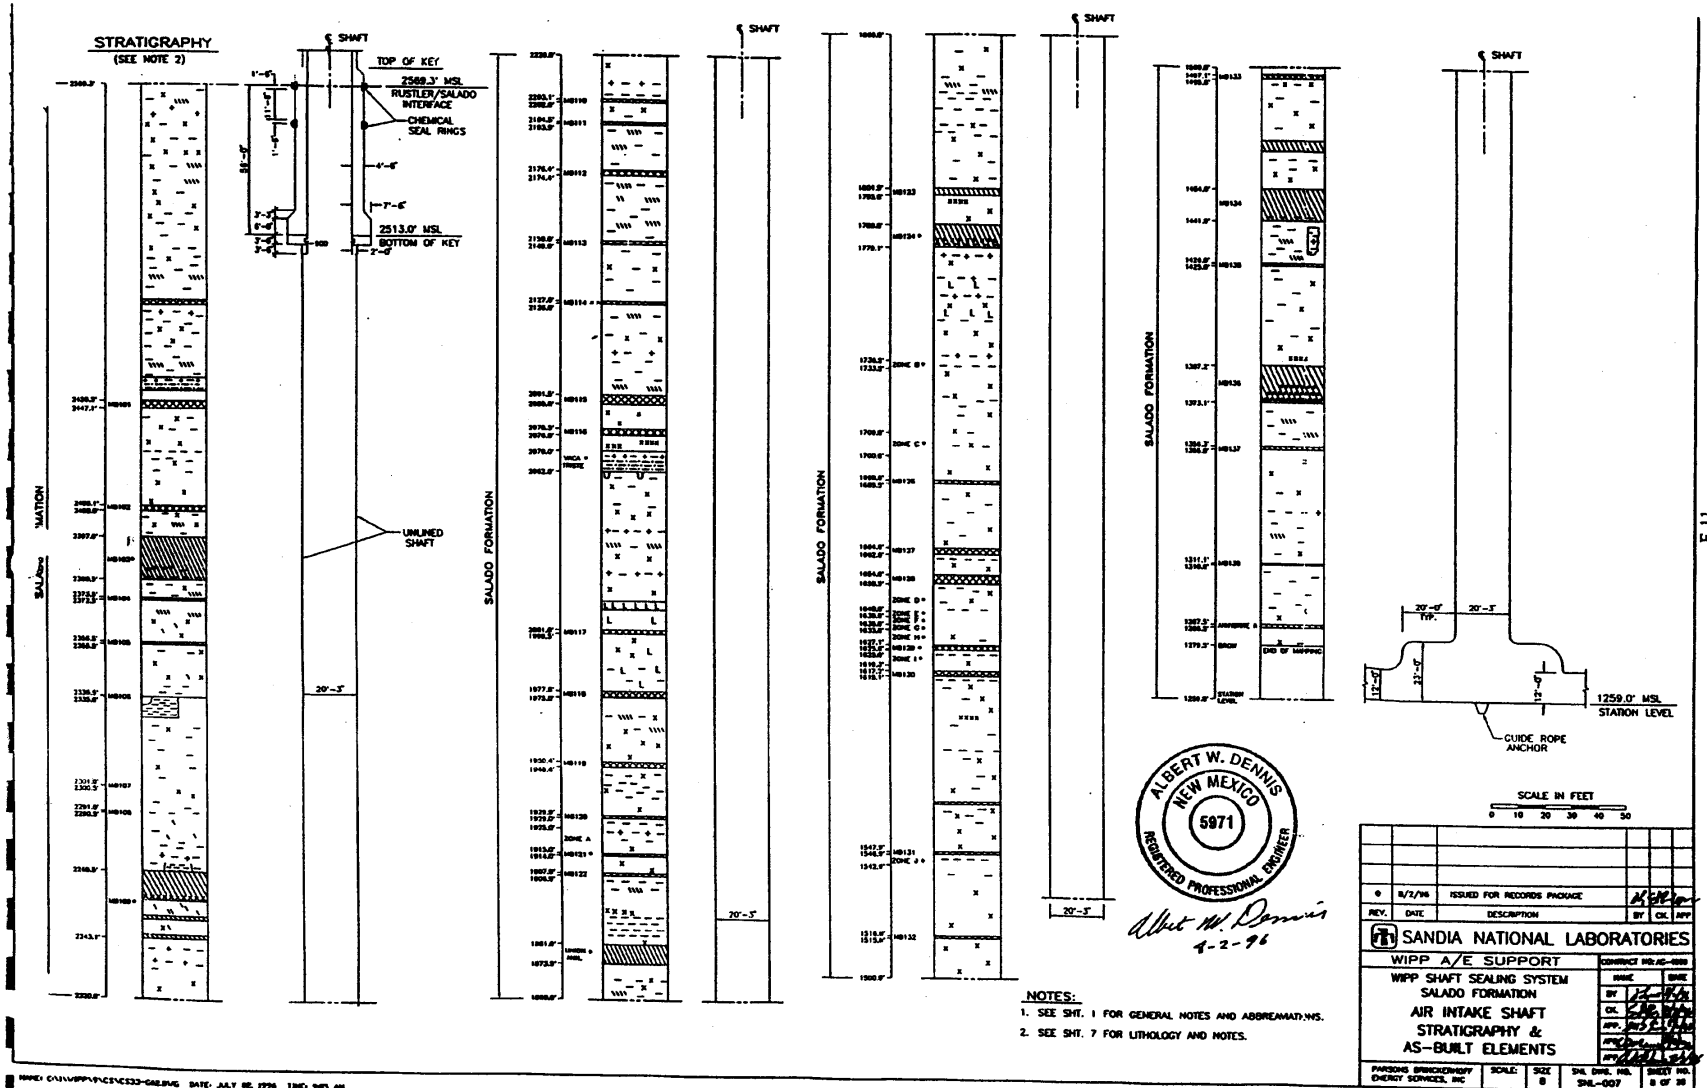

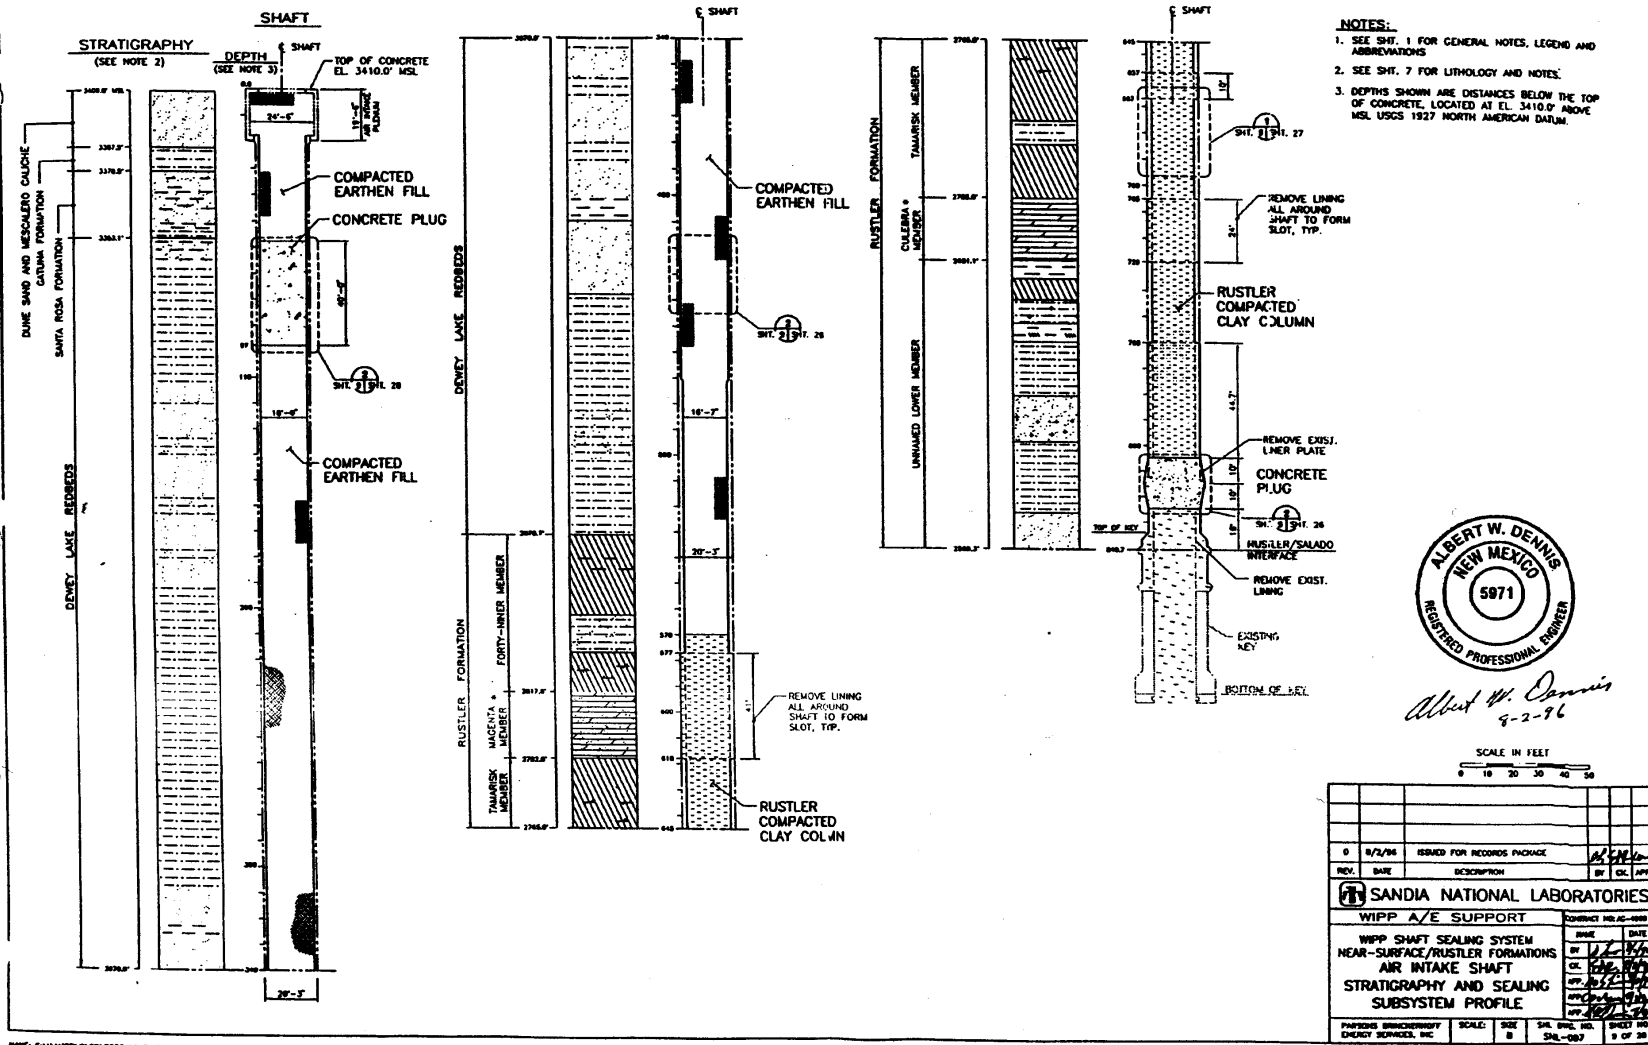

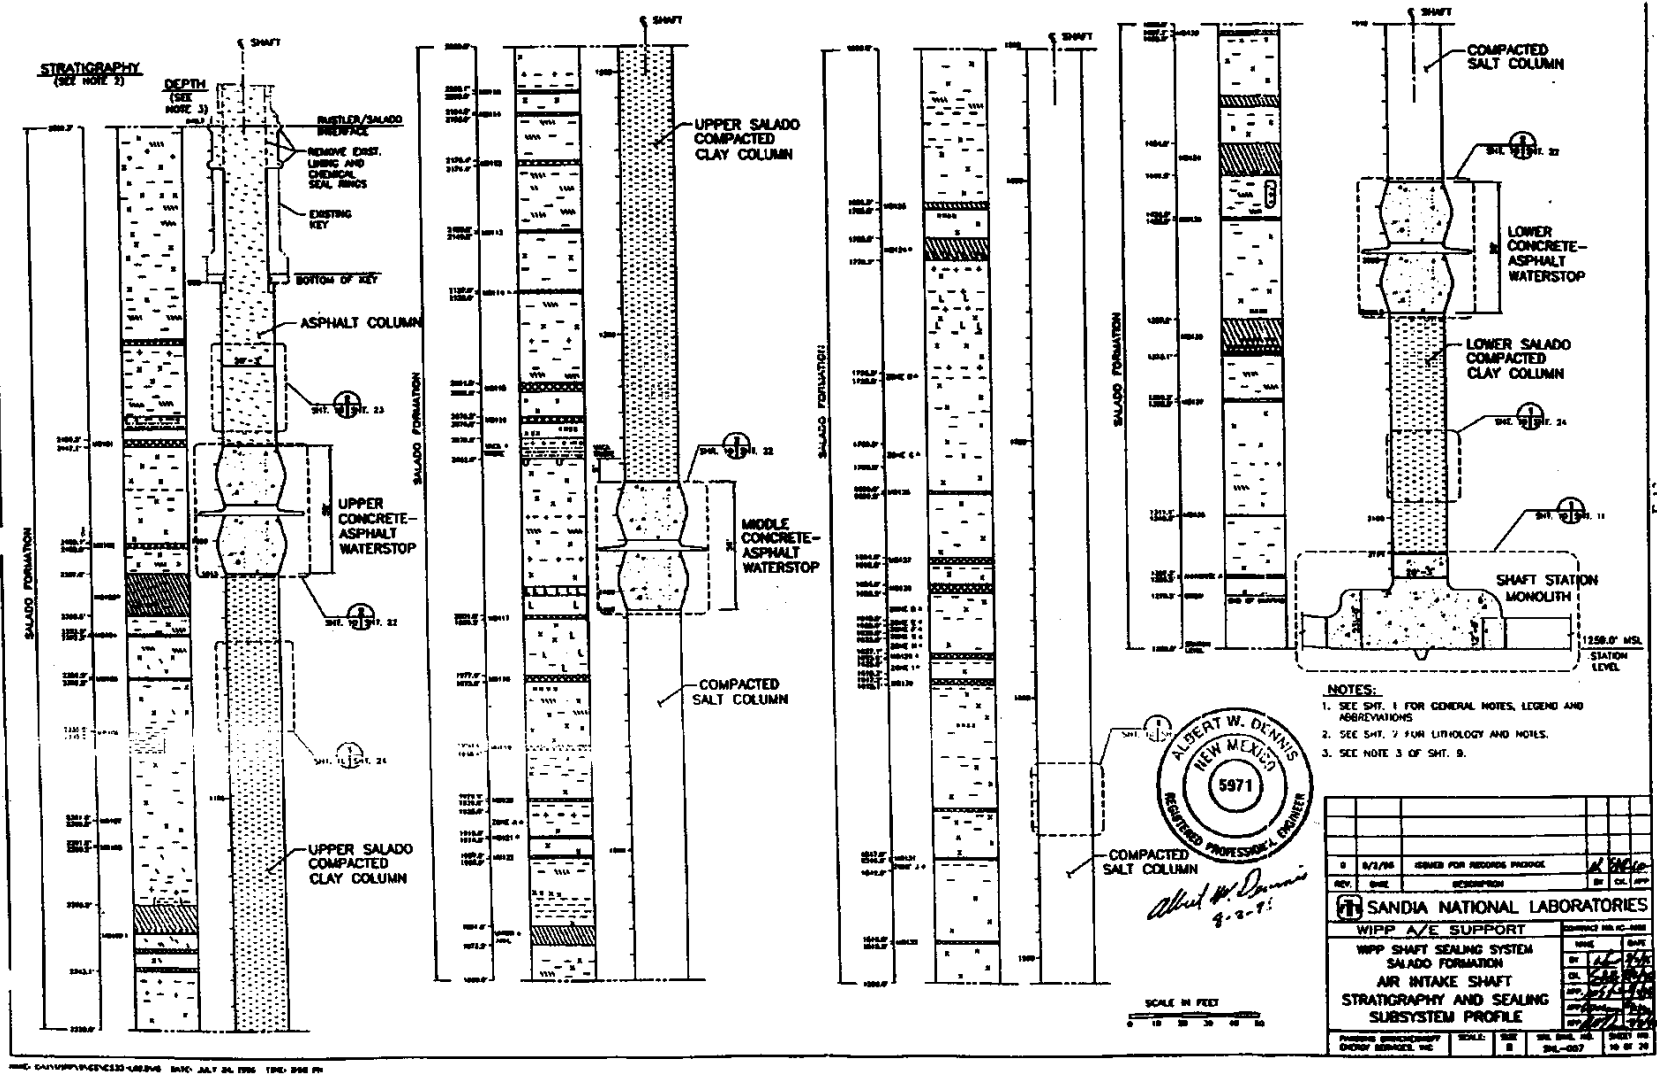

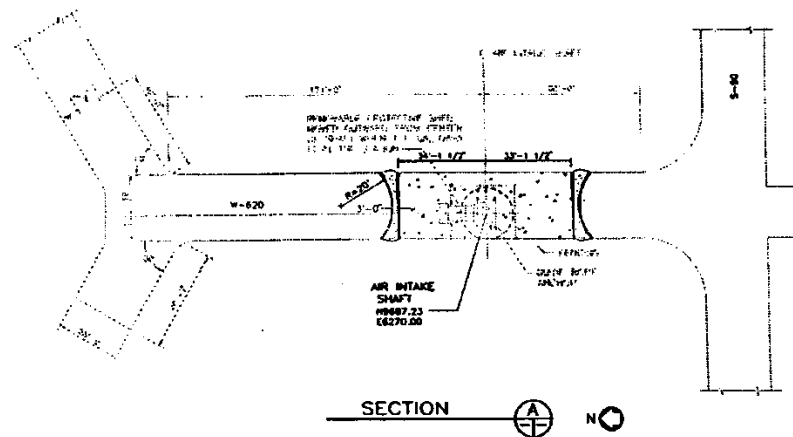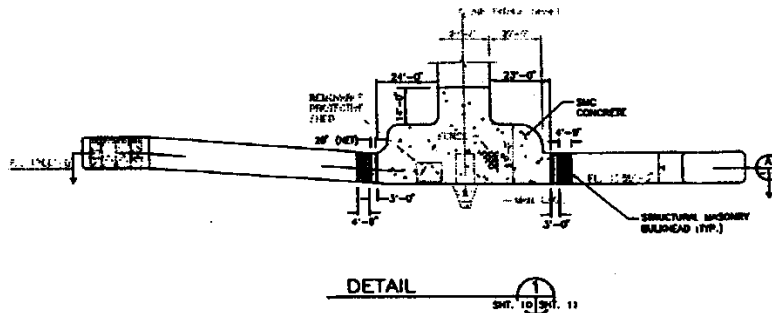


NOTES:  
1. SEE SMT. 1 FOR GENERAL NOTES, LEGEND AND ABBREVIATIONS.




*A. W. Dennis*  
9-2-96

SCALE IN FEET  
0 10 20 30 40


REV.		DATE	DESCRIPTION	BY	CHK.
<b>SANDIA NATIONAL LABORATORIES</b> WIPP A/E SUPPORT WIPP SHAFT SEALING SYSTEM AIR INTAKE SHAFT SHAFT STATION MONOLITH					
PROJECT NO. 94-000000 SHEET NO. 11 OF 28				DATE: 9-2-96 BY: [Signature] CHK: [Signature]	

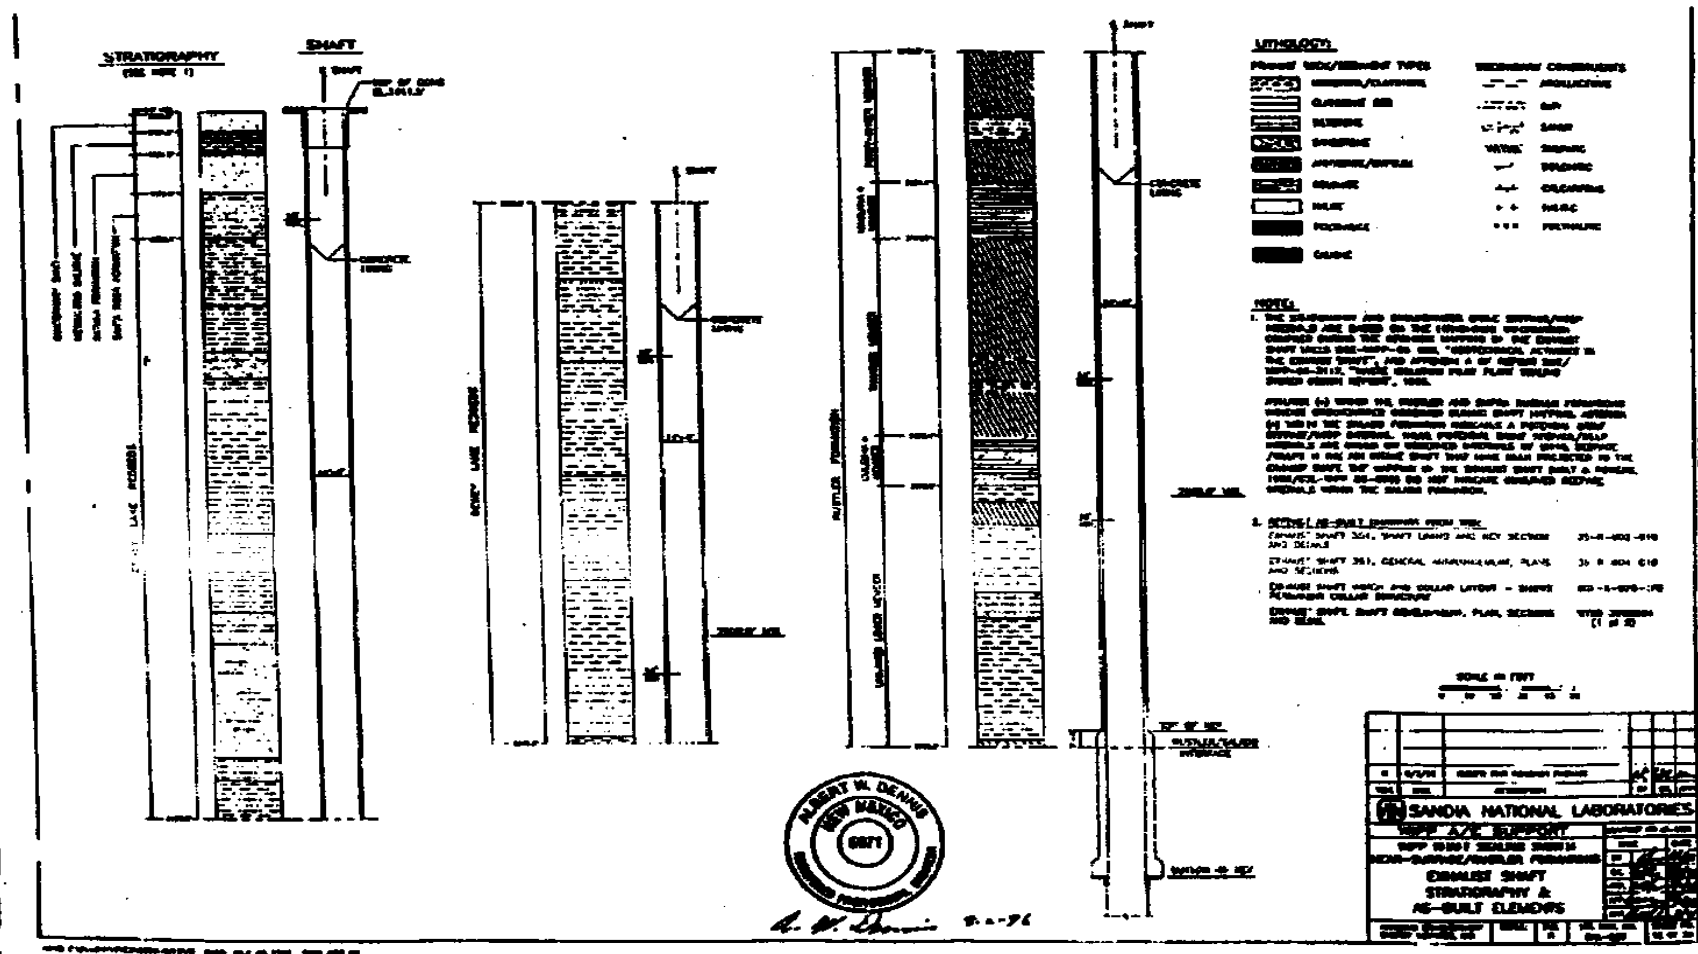

Waste Isolation Pilot Plant  
Hazardous Waste Permit  
October 27, 1999


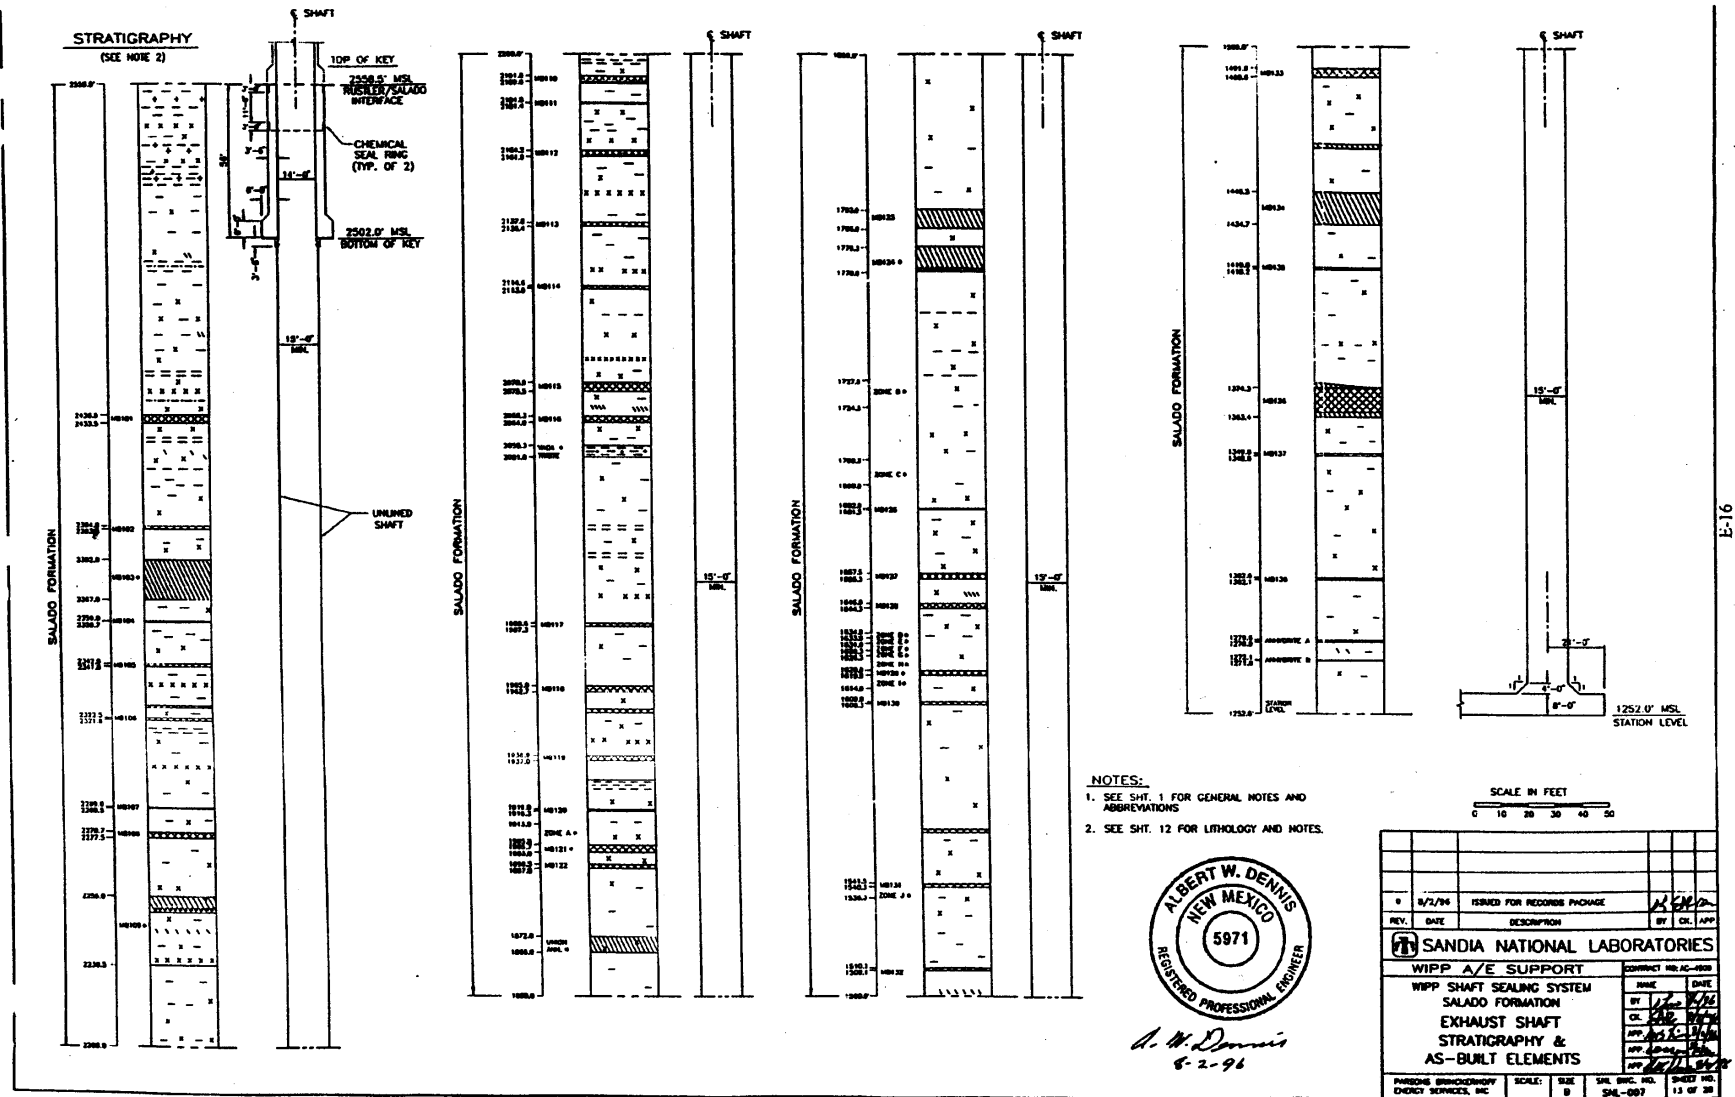




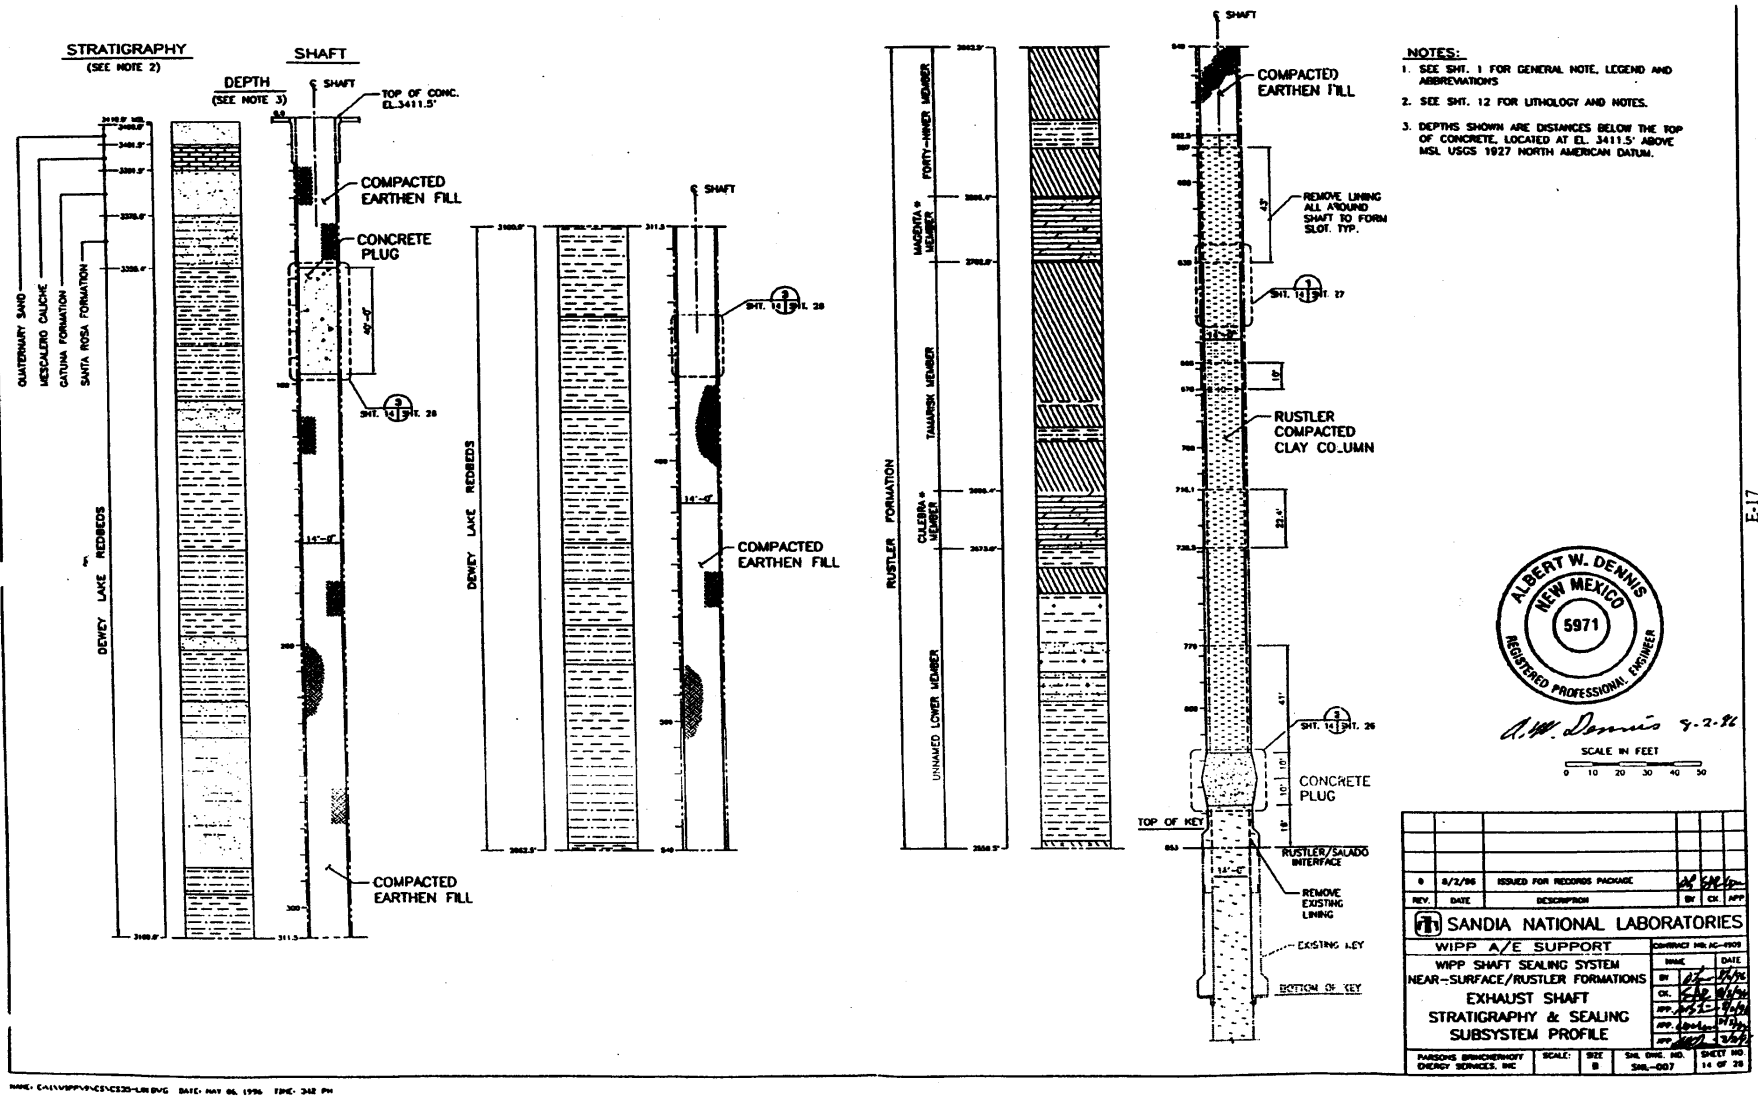


١



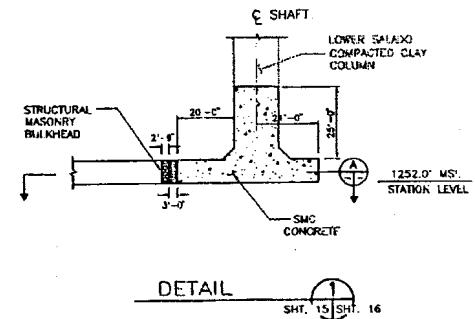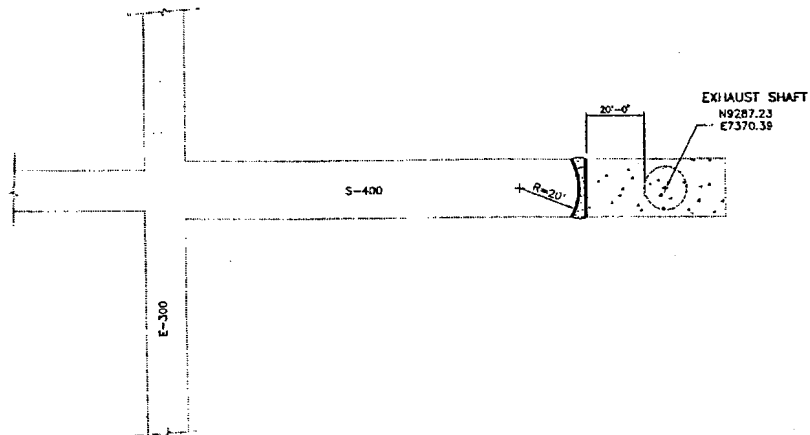


NOTES:


1. SEE SHT. 1 FOR GENERAL NOTES, LEGEND AND ABBREVIATIONS.

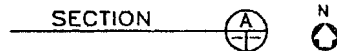


*A. W. Dennis 8-2-96*

0	8/2/85	ISSUED FROM REVISION PACKAGE	BY	DATE
REV.	DATE	DESCRIPTION	BY	DATE
SANDIA NATIONAL LABORATORIES				
WIPP A/E SUPPORT				
WIPP SHAFT SEALING SYSTEM				
CONTRACT NO. NS-4009			NAME	DATE
			BY	DATE

 

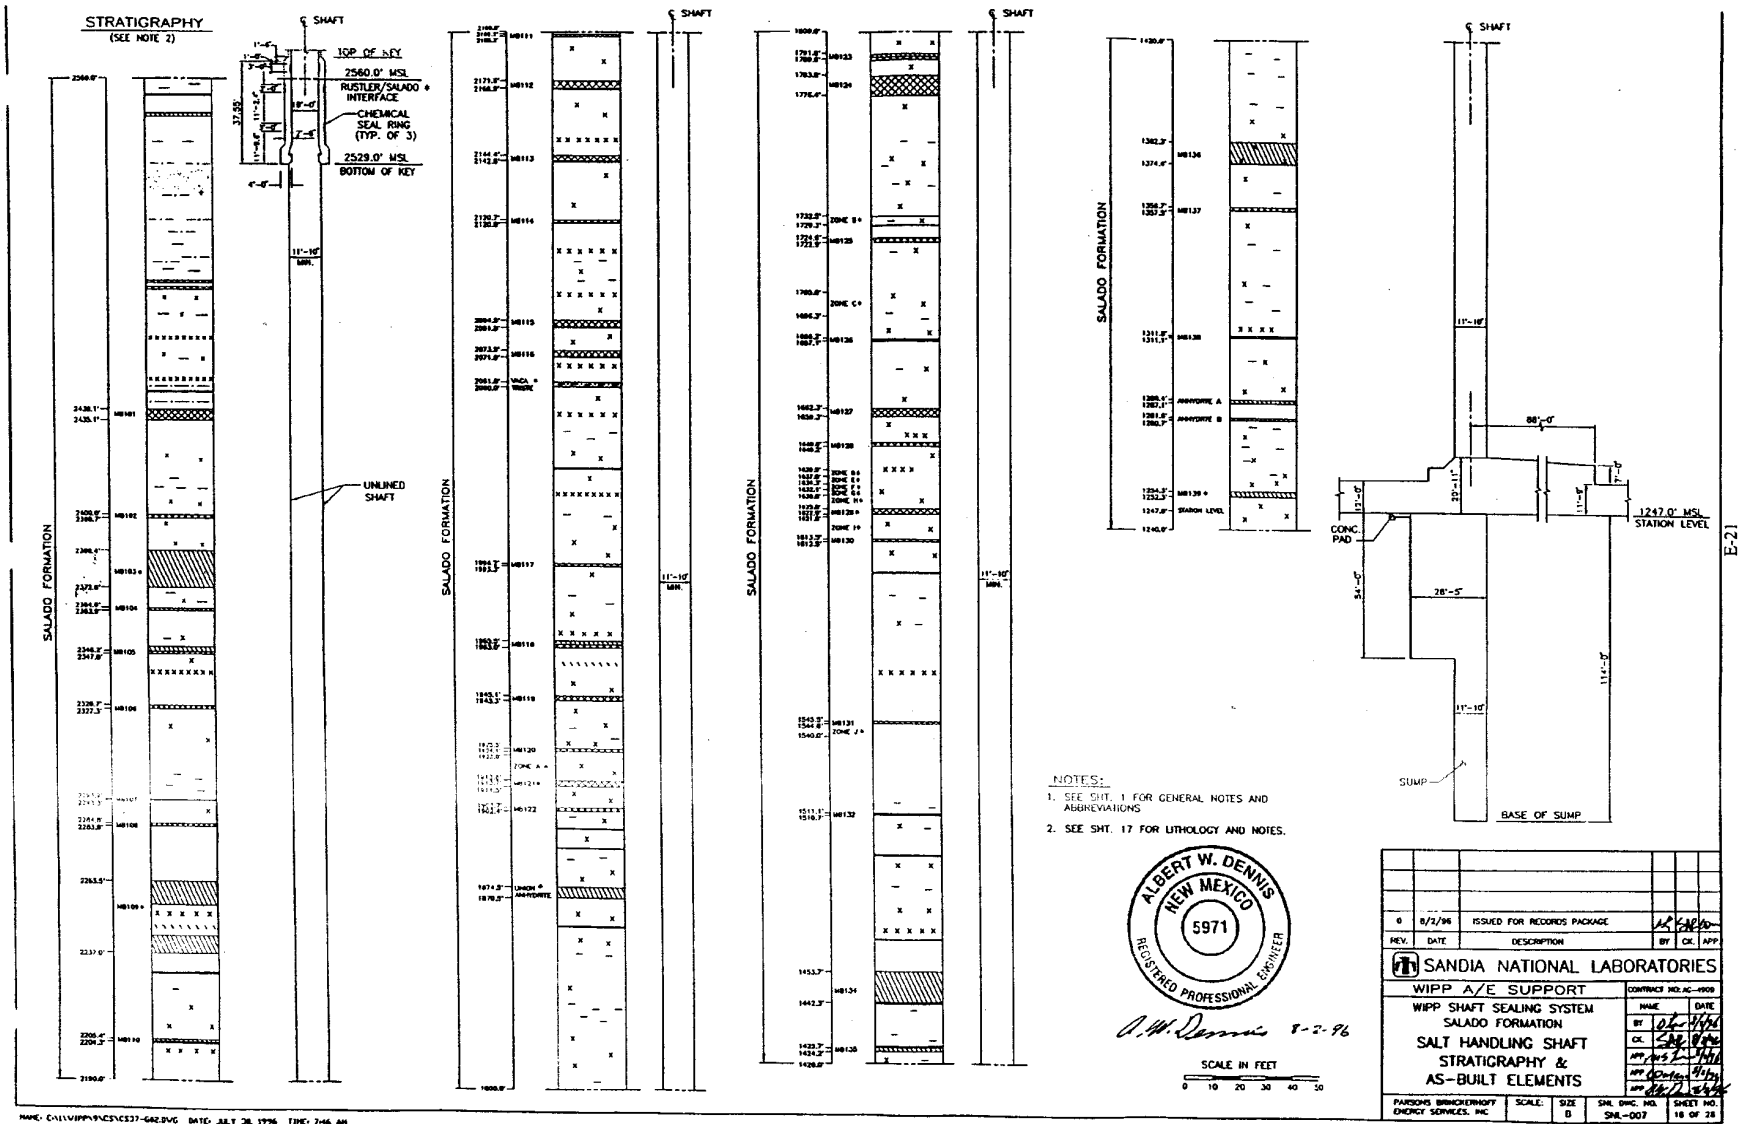

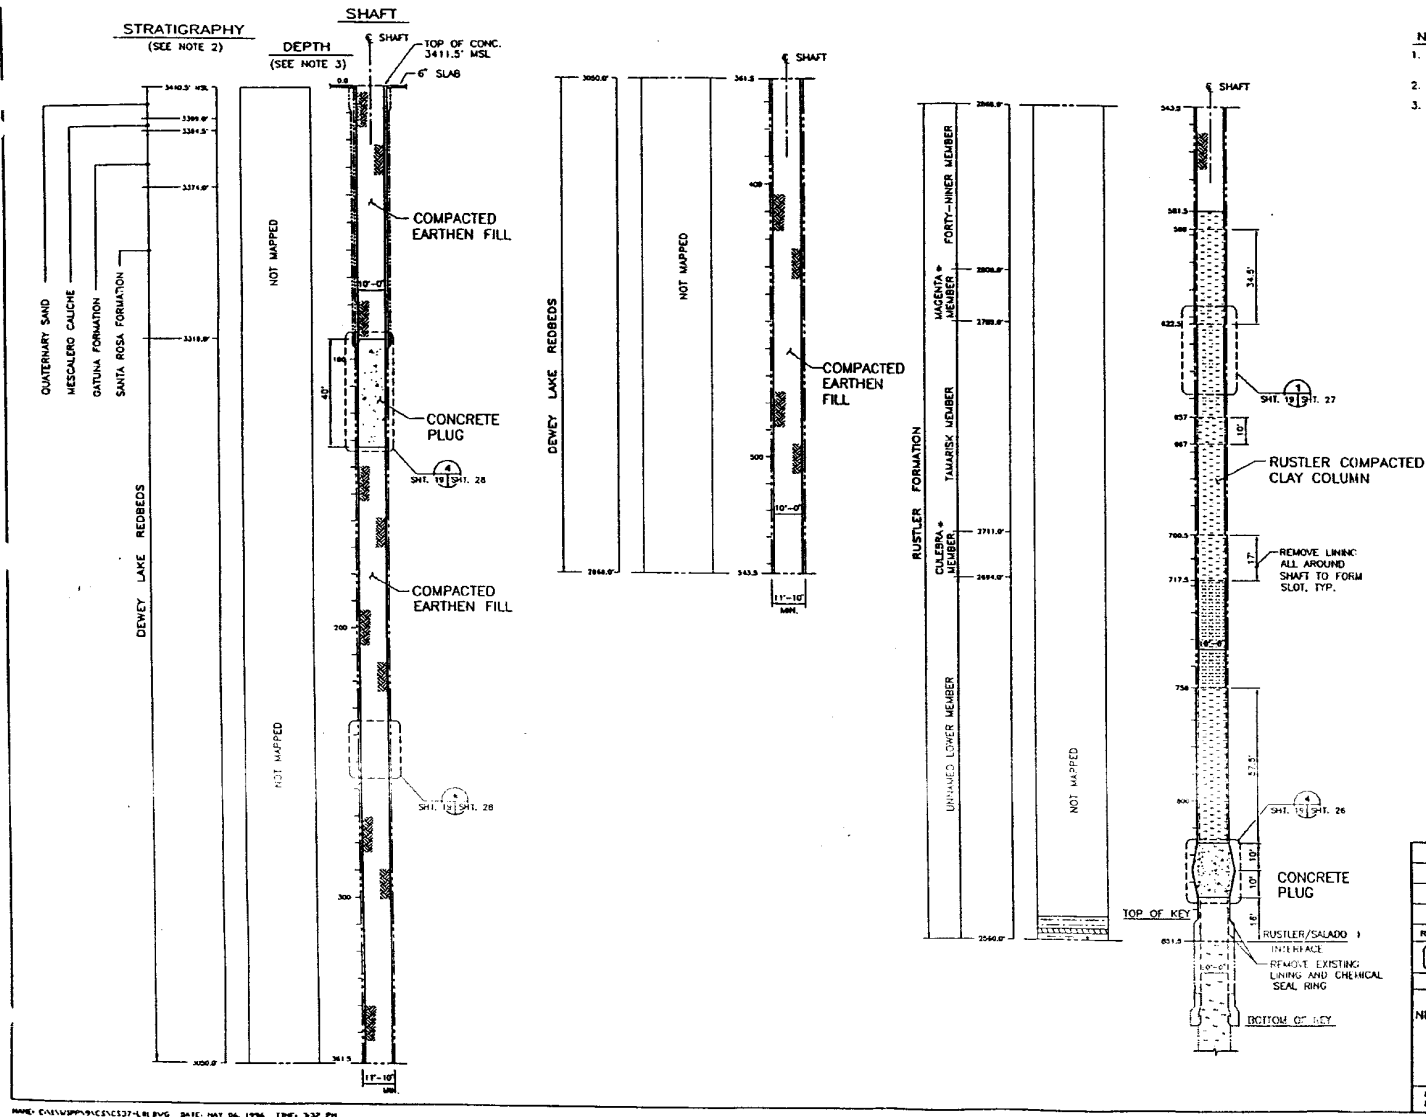

- NOTES:**
1. SEE SHT. 1 FOR GENERAL NOTES, LEGEND AND ABBREVIATIONS.
  2. SEE SHT. 17 FOR LITHOLOGY AND NOTES.
  3. DEPTHS SHOWN ARE DISTANCES BELOW THE TOP OF CONCRETE, LOCATED AT EL. 3411.5' ABOVE MSL USGS 1927 NORTH AMERICAN DATUM.






*Albert W. Dennis 9-2-96*

SCALE IN FEET  
0 10 20 30 40 50

0	8/2/96	ISSUED FOR RECORDS PACKAGE	BY: <i>AL</i>	DATE: <i>8/2/96</i>
REV.	DATE	DESCRIPTION	BY	CHK. APP.
SANDIA NATIONAL LABORATORIES				
WIPP A/E SUPPORT				
WIPP SHAFT SEALING SYSTEM			NAME	DATE
NEAR-SURFACE/RUSTLER FORMATIONS			BY: <i>AL</i>	<i>8/2/96</i>
SALT HANDLING SHAFT			CHK: <i>AL</i>	<i>8/2/96</i>
STRATIGRAPHY & SEALING			APP: <i>AL</i>	<i>8/2/96</i>
SUBSYSTEM PROFILE			APP: <i>AL</i>	<i>8/2/96</i>
PARSONS BRINCKERHOFF ENERGY SERVICES, INC.		SCALE: 8	SHEET NO. 19 OF 28	SHEET NO. 19 OF 28



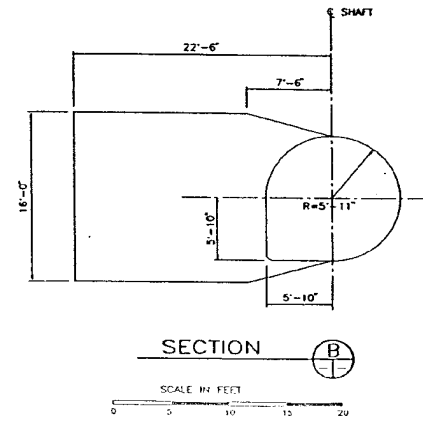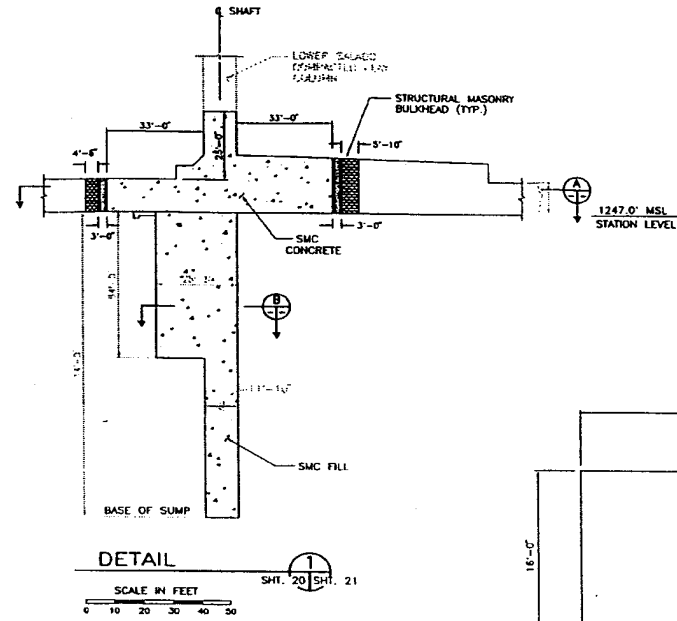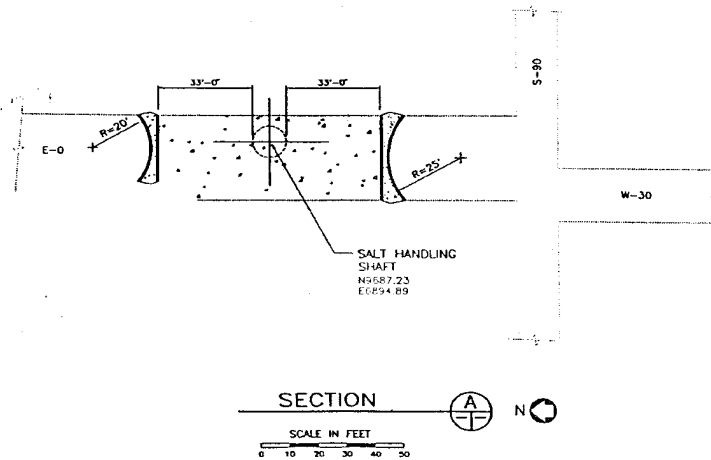






NOTES:  
1. SEE SHT. 1 FOR GENERAL NOTES, LEGEND AND ABBREVIATIONS.




*Albert W. Dennis*  
8-2-96

REV.	DATE	DESCRIPTION	BY	CHK.	APP.
0	8/2/96	ISSUED FOR RECORDS PACKAGE			
SANDIA NATIONAL LABORATORIES					
WIPP A/E SUPPORT					
WIPP SHAFT SEALING SYSTEM					
SALT HANDLING SHAFT SHAFT STATION MONOLITH					
NAME	DATE	CONTRACT NO.	AC-4809		
BY					
CHK.					
APP.					
APP.					
APP.					
PARSONS BRINCKERHOFF ENERGY SERVICES, INC.	SCALE:	SIZE	SHEET NO.	SHEET NO.	
	B	B	SHL-007	21 OF 28	




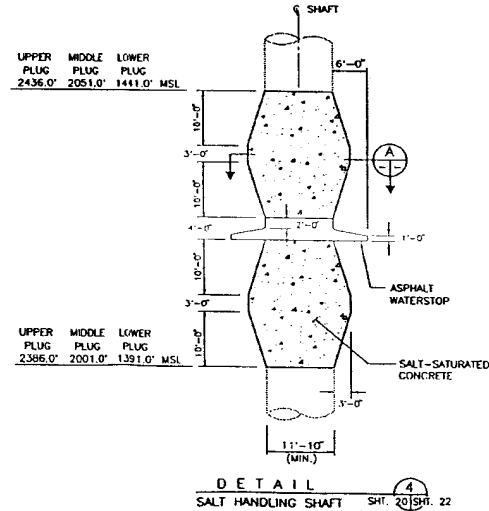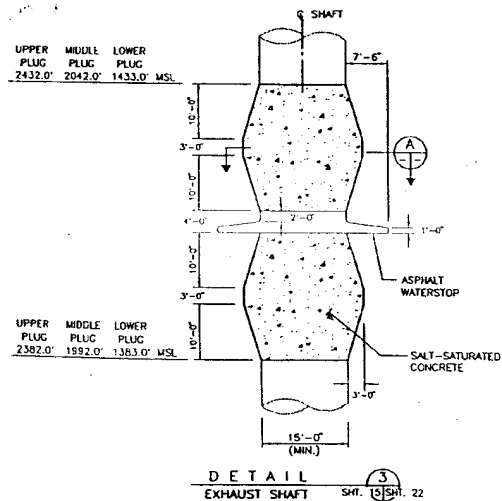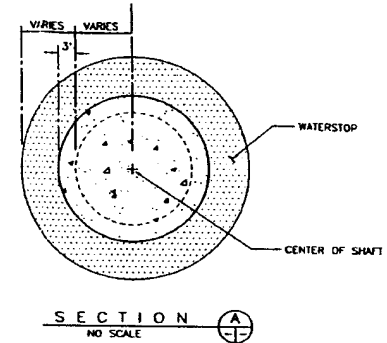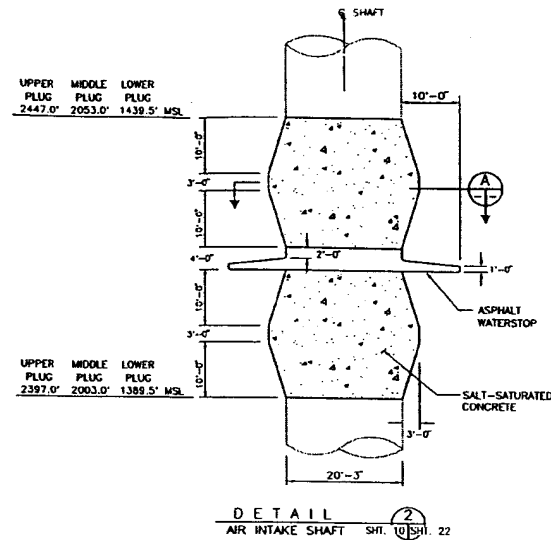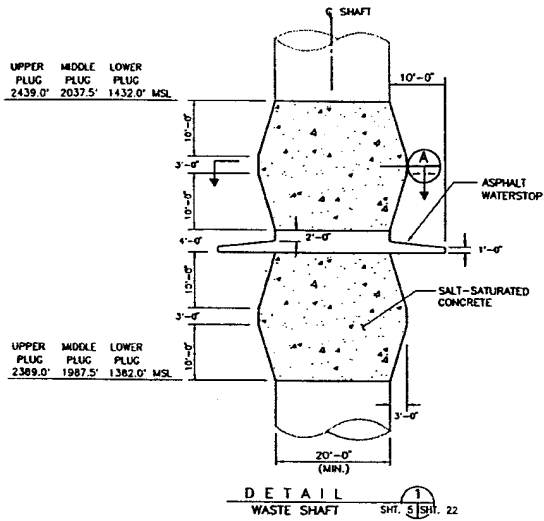


*Albert W. Dennis*  
1-2-96

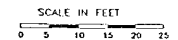

0	8/2/96	ISSUED FOR RECORDS PACKAGE	BY	CK	APP
REV.	DATE	DESCRIPTION	BY	CK	APP
SANDIA NATIONAL LABORATORIES					
WIPP A/E SUPPORT					
WIPP SHAFT SEALING SYSTEM					
CONCRETE-ASPHALT WATERSTOP IN SALADO FORMATION					
NAME	DATE	CONTRACT NO.	NO.	NO.	NO.
BY	DATE	NO.	NO.	NO.	NO.
CK	DATE	NO.	NO.	NO.	NO.
APP	DATE	NO.	NO.	NO.	NO.
APP	DATE	NO.	NO.	NO.	NO.
PARSONS BRINCKERHOFF	SCALE:	SIZE	S&L DWG. NO.	SHEET NO.	
ENERGY SERVICES, INC.	B	B	S&L-007	22 OF 78	

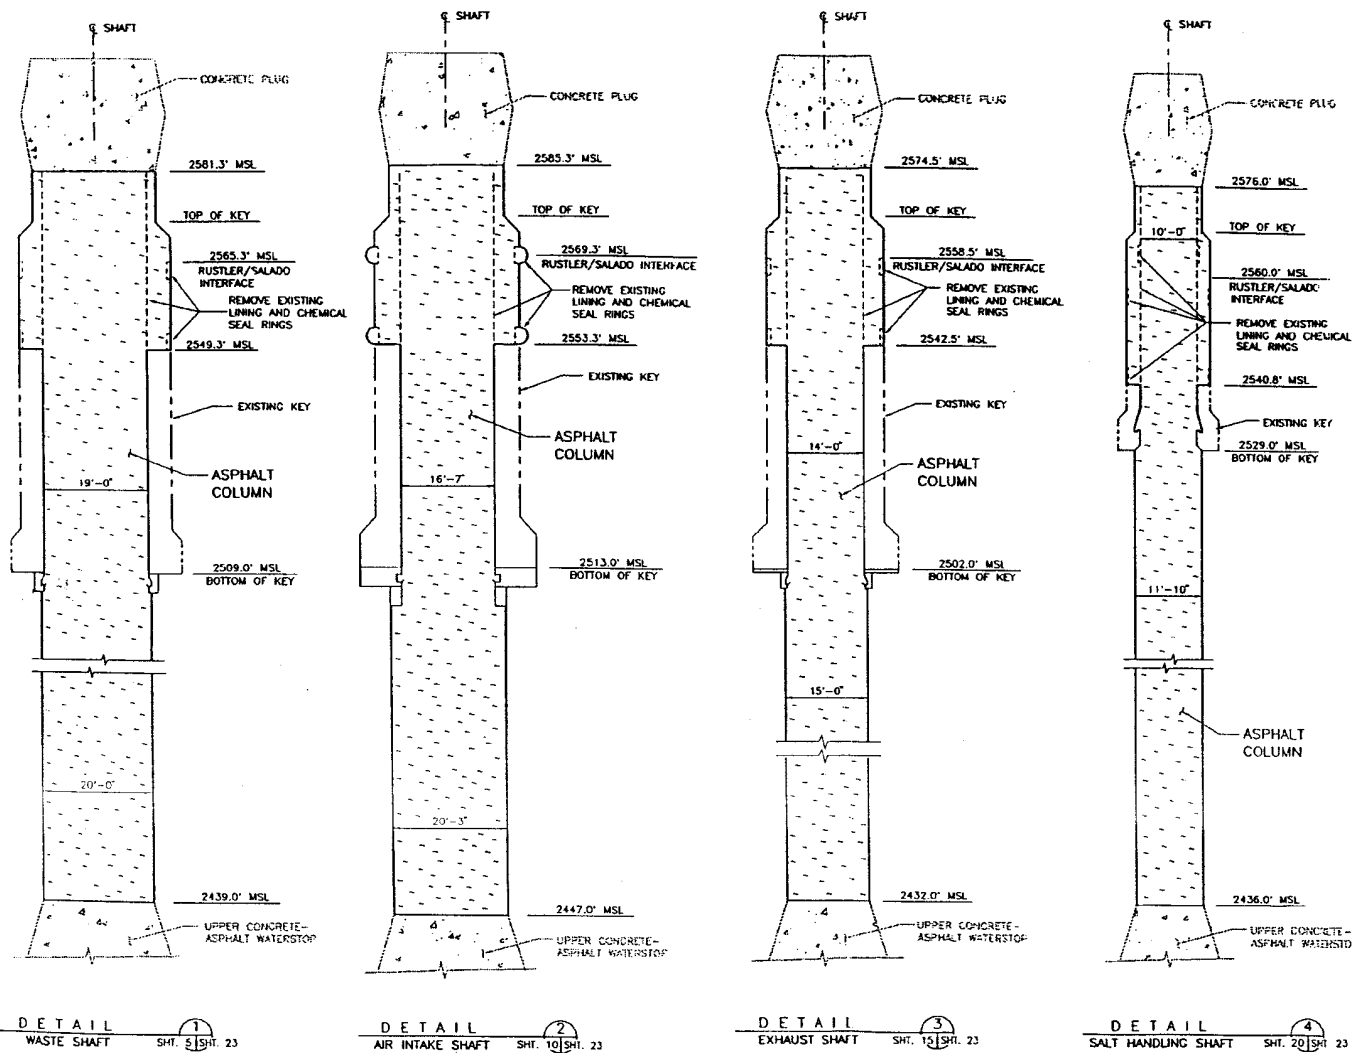


*Albert W. Dennis*  
8-2-96

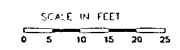

0	5	10	15	20	25								
SCALE IN FEET													
<table border="1"> <tr> <td>0</td> <td>8/2/96</td> <td>ISSUED FOR RECORDS PACKAGE</td> <td>BY: [Signature]</td> </tr> <tr> <td>REV.</td> <td>DATE</td> <td>DESCRIPTION</td> <td>BY: CK: APP</td> </tr> </table>						0	8/2/96	ISSUED FOR RECORDS PACKAGE	BY: [Signature]	REV.	DATE	DESCRIPTION	BY: CK: APP
0	8/2/96	ISSUED FOR RECORDS PACKAGE	BY: [Signature]										
REV.	DATE	DESCRIPTION	BY: CK: APP										
<b>SANDIA NATIONAL LABORATORIES</b> WIPP A/E SUPPORT WIPP SHAFT SEALING SYSTEM ASPHALT COLUMN													
CONTRACT NO. AC-4009 NAME: [Signature] DATE: 8/2/96 BY: [Signature] CK: [Signature] APP: [Signature]		SHEET NO. 23 OF 28											

NAME: C:\V\WIPP\DESIGN\100-100.DWG DATE: MAY 06, 1996 TIME: 4:09 PM

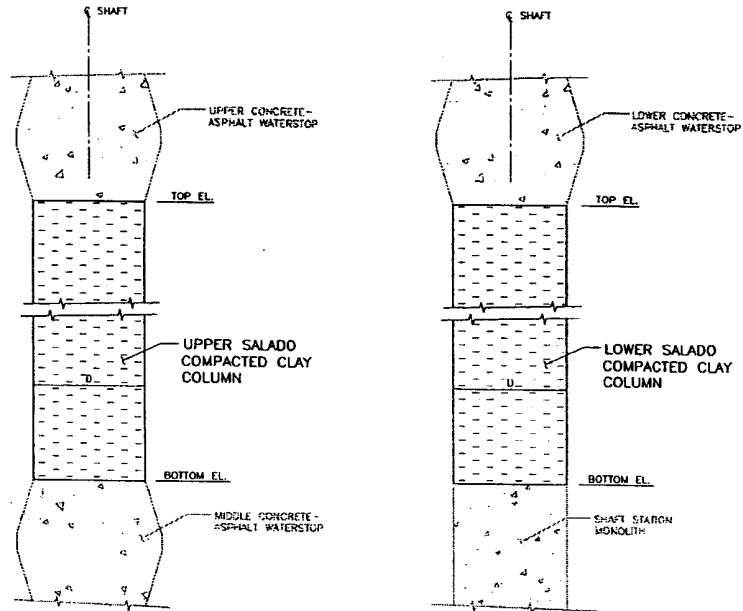

DETAIL  
SEE TABLE 1 FOR DETAILS  
NO SCALE

SHT. 5  
SHT. 10  
SHT. 15  
SHT. 20

1  
SHT. 24

TABLE 1

SHAFT	NOMINAL SHAFT DIAMETER D	UPPER SALADO COMPACTED CLAY COLUMN			LOWER SALADO COMPACTED CLAY COLUMN		
		TOP EL. (FT. MSL)	BOTTOM EL. (FT. MSL)	TOTAL HT. (FT.)	TOP EL. (FT. MSL)	BOTTOM EL. (FT. MSL)	TOTAL HT. (FT.)
WASTE	20'-0"	2389.0	2037.5	351.5	1382.0	1286.0	96.0
AIR INTAKE	20'-3"	2397.0	2053.0	344.0	1389.5	1296.0	93.5
EXHAUST	15'-0"	2382.0	2042.0	340.0	1383.0	1285.0	98.0
SALT HANDLING	11'-10"	2386.0	2051.0	335.0	1391.0	1284.0	107.0




Albert W. Dennis  
9-2-96

0	8/2/96	ISSUED FOR RECORDS PACKAGE	BY: [Signature]
REV.	DATE	DESCRIPTION	BY: CK, APP
<b>SANDIA NATIONAL LABORATORIES</b> WIPP A/E SUPPORT WIPP SHAFT SEALING SYSTEM UPPER AND LOWER SALADO COMPACTED CLAY COLUMNS			
CONTRACT NO. AC-0005 NAME: [Signature] DATE: [Signature] CK: [Signature] APP: [Signature]		SCALE: [Signature] SIZE: [Signature] SML. Dwg. No.: SML-007 SHEET NO.: 24 OF 28	

NAME: C:\VIPP\PROJECTS\00-584-BUG DATE: MAY 06, 1996 TIME: 4:52 PM

Waste Isolation Pilot Plant  
Hazardous Waste Permit  
October 27, 1999

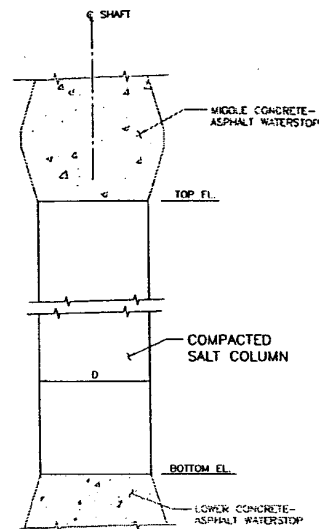

DETAIL  
SEE TABLE 1 FOR DETAILS  
NO SCALE

1  
SHT. 5 SHT. 25  
SHT. 10  
SHT. 15  
SHT. 20

TABLE 1

SHAFT	NOMINAL SHAFT DIAMETER D	COMPACTED SALT COLUMN		
		TOP EL. (FT. MSL)	BOTTOM EL. (FT. MSL)	TOTAL HT. (FT.)
WASTE	20'-0"	1987.5	1432.0	555.5
AIR INTAKE	20'-3"	2003.0	1439.5	563.5
EXHAUST	15'-0"	1992.0	1433.0	559.0
SALT HANDLING	11'-10"	2001.0	1441.0	560.0



*Albert W. Dennis*  
8-2-96


0	8/2/96	ISSUED FOR RECORDS PACKAGE	BY: <i>AKH</i>
REV.	DATE	DESCRIPTION	BY: <i>AKH</i>
<b>SANDIA NATIONAL LABORATORIES</b> WIPP A/E SUPPORT WIPP SHAFT SEALING SYSTEM COMPACTED SALT COLUMN			
NAME: <i>AKH</i> DATE: <i>8/2/96</i>		CONTRACT NO. AC-480B SHEET NO. 25 OF 28	

WIPP-SALT/SHIELD/PROCESSOR-185.DWG DATE: MAY 06, 1996 TIME: 4:14 PM

### WIPP Shaft Sealing System Concrete Plug

Drawing SNL 007 26 of 28 not currently available. Drawing is not displayed in the Permit.

Waste Isolation Pilot Plant  
Hazardous Waste Permit  
October 27, 1999

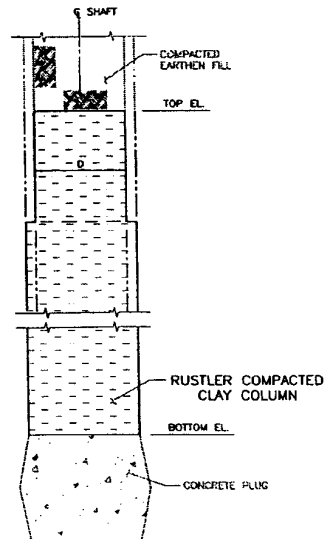

DETAIL  
SEE TABLE 1 FOR DETAILS  
NO SCALE

SH. 4  
SH. 9  
SH. 14  
SH. 19

SH. 27

TABLE 1


SHAFT	NOMINAL SHAFT DIAMETER D	RUSTLER COMPACTED CLAY COLUMN		
		TOP EL. (FT. MSL)	BOTTOM EL. (FT. MSL)	TOTAL HT. (FT.)
WASTE	19'-0"	2836.0	2601.3	234.7
AIR INTAKE	16'-7"	2840.0	2605.3	234.7
EXHAUST	14'-0"	2829.0	2594.5	234.5
SALT HANDLING	10'-0"	2830.0	2596.0	234.0



*Albert W. Dennis*  
9-2-96

REV.	DATE	DESCRIPTION	BY	CHK	APP
1	8/1/96	ISSUED FOR RECORDS PACKAGE	AWD		
SANDIA NATIONAL LABORATORIES					
WIPP A/E SUPPORT					
WIPP SHAFT SEALING SYSTEM					
RUSTLER COMPACTED CLAY COLUMN					
PARSONS BRINCKERHOFF ENERGY SERVICES, INC.			SCALE:	SIZE:	SHEET NO.
			8	27 OF 28	

E-30

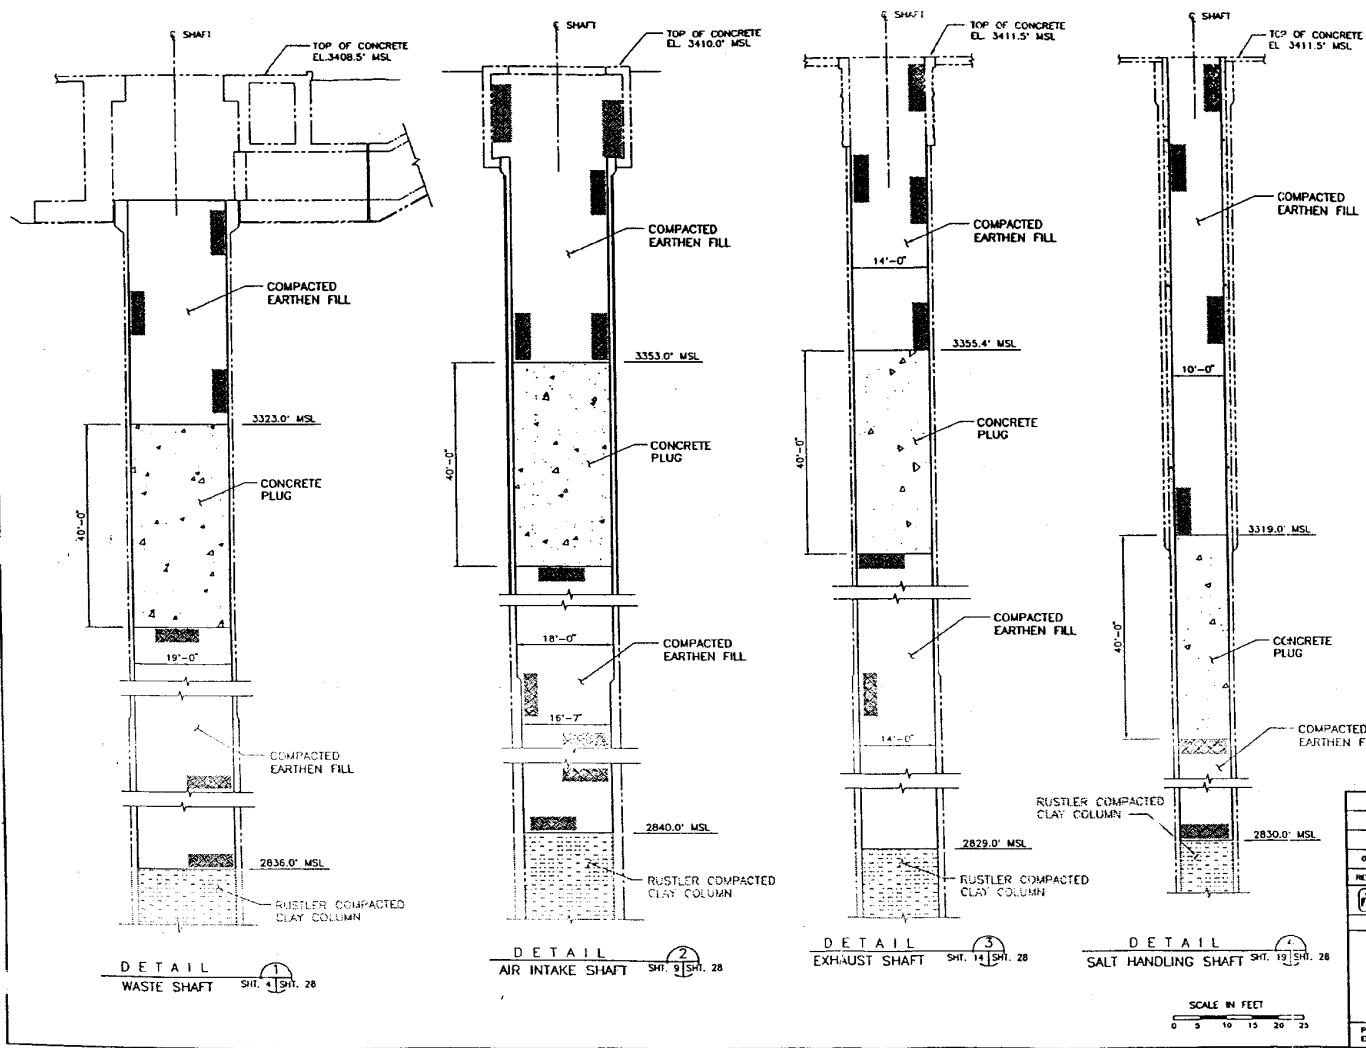


*Albert W. Dennis*  
9-2-96

0	8/2/96	ISSUED FOR RECORDS PACKAGE	BY: SH. 28
REV.	DATE	DESCRIPTION	BY: CL. APP.
SANDIA NATIONAL LABORATORIES			
WIPP A/E SUPPORT		CONTRACT NO. AC-4999	
WIPP SHAFT SEALING SYSTEM		NAME	DATE
COMPACTED EARTHEN FILL AND CONCRETE PLUG		BY: SH. 28	8/2/96
		CL: SH. 28	8/2/96
		APP: SH. 28	8/2/96
		APP: SH. 28	8/2/96
PARSONS BRINCKERHOFF	SCALE	SIZE	S&L DPC NO.
ENERGY SERVICES, INC.		B	S&L-007
			SHEET NO. 28 OF 28


WASTE ISOLATION PILOT PLANT  
CARLSBAD, NM  
SHAFT SEALING SYSTEM DESIGN  
EQUIPMENT AND CONSTRUCTION SKETCHES

DRAWING NUMBER	TITLE
SKETCH E-1	WIPP SHAFT SEALING SYSTEM SMALLER GALLOWAY GENERAL ARRANGEMENT PLANS AND SECTIONS
SKETCH E-2	WIPP SHAFT SEALING SYSTEM LARGER GALLOWAY GENERAL ARRANGEMENT PLANS AND SECTIONS
SKETCH E-3	WIPP SHAFT SEALING SYSTEM TYPICAL HEADFRAME PLANS AND SECTIONS
SKETCH E-4	WIPP SHAFT SEALING SYSTEM PERSPECTIVE HEADFRAME AND ASSOCIATED SURFACE FACILITIES




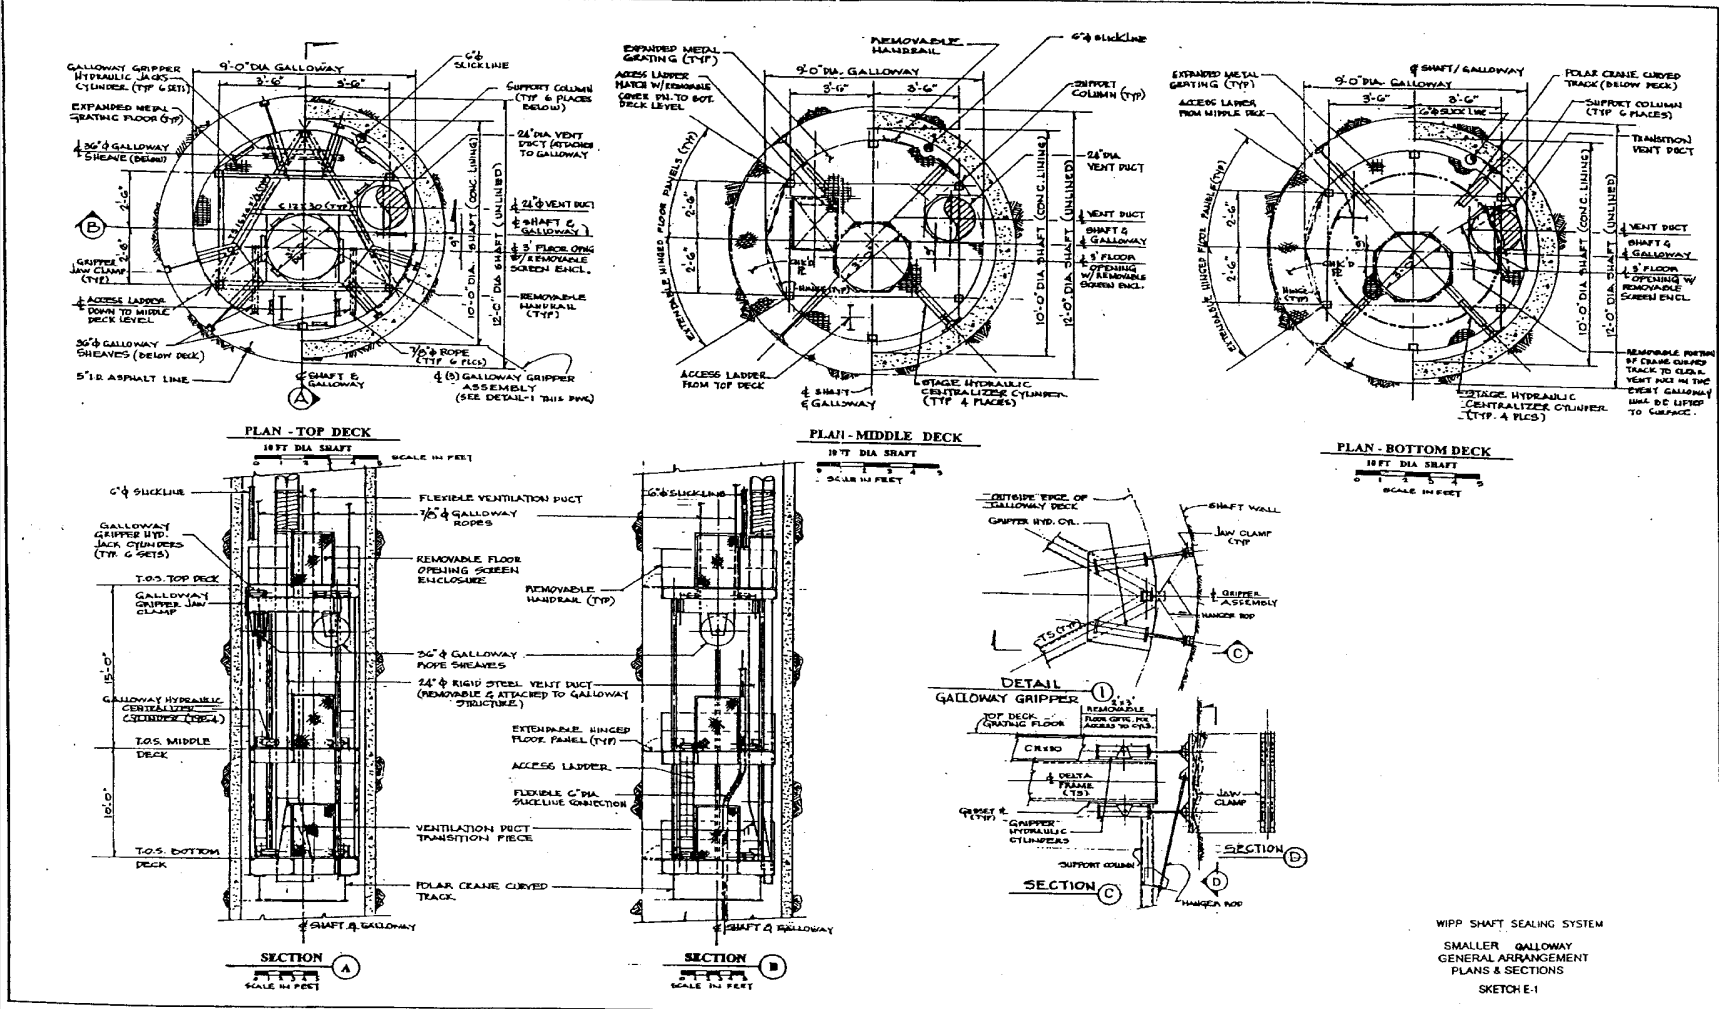


WIPP Shaft Sealing System Smaller Galloway Genral Arrangement Plans and Sections

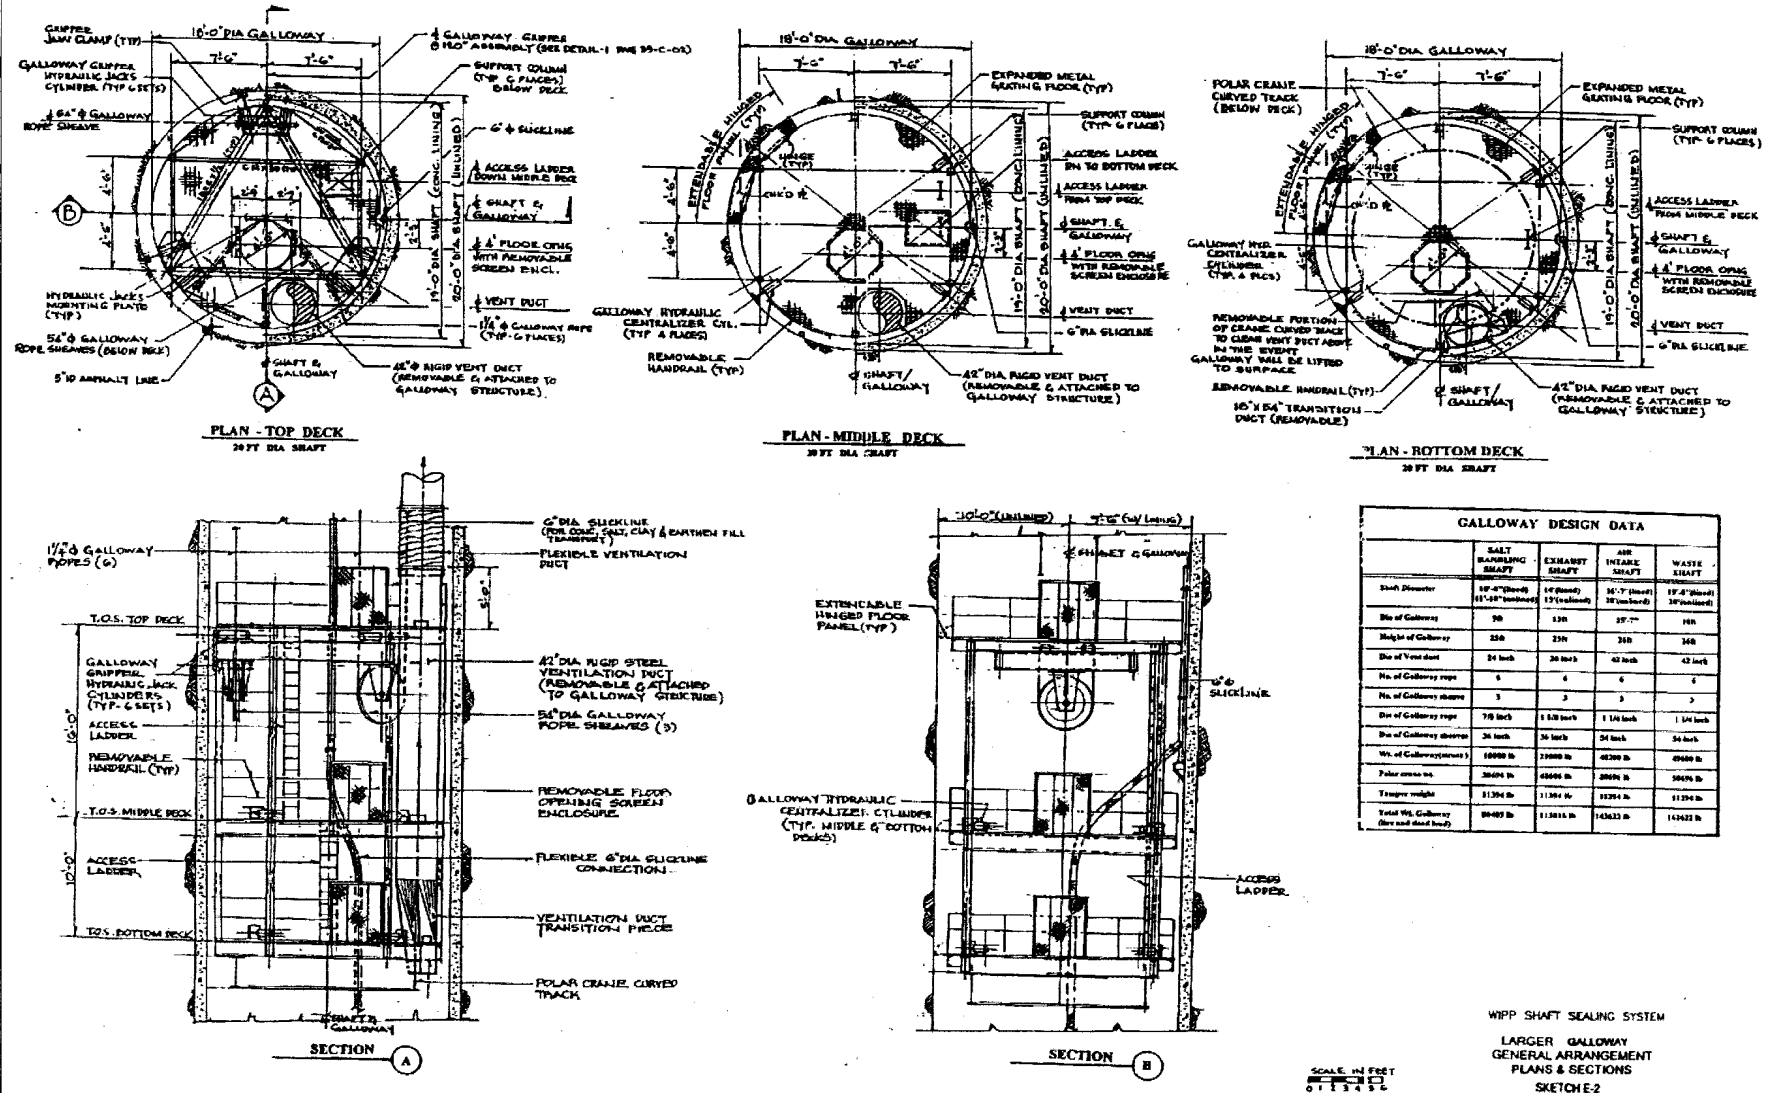

WIPP Shaft Sealing System Larger Galloway General Arrangement Plans and Sections

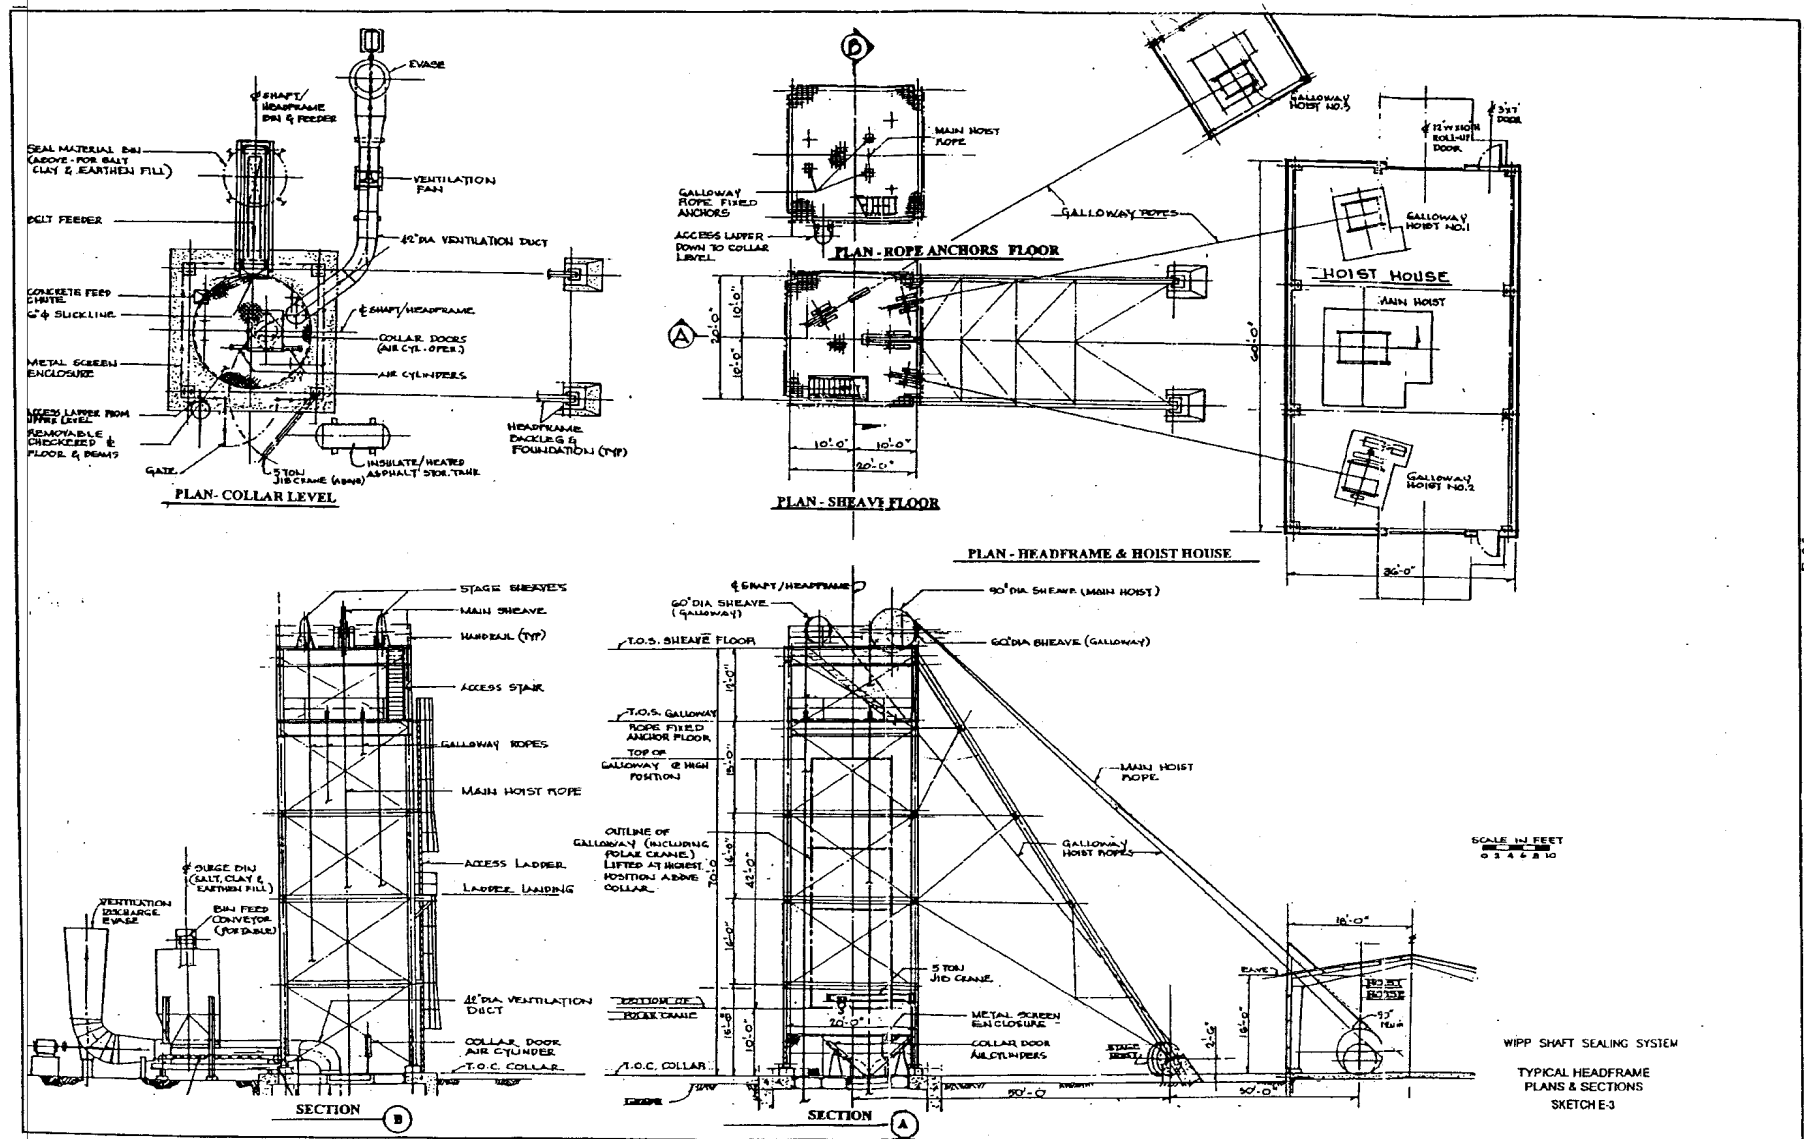

WIPP Shaft Sealing System Typical Headframe Plans and Sections

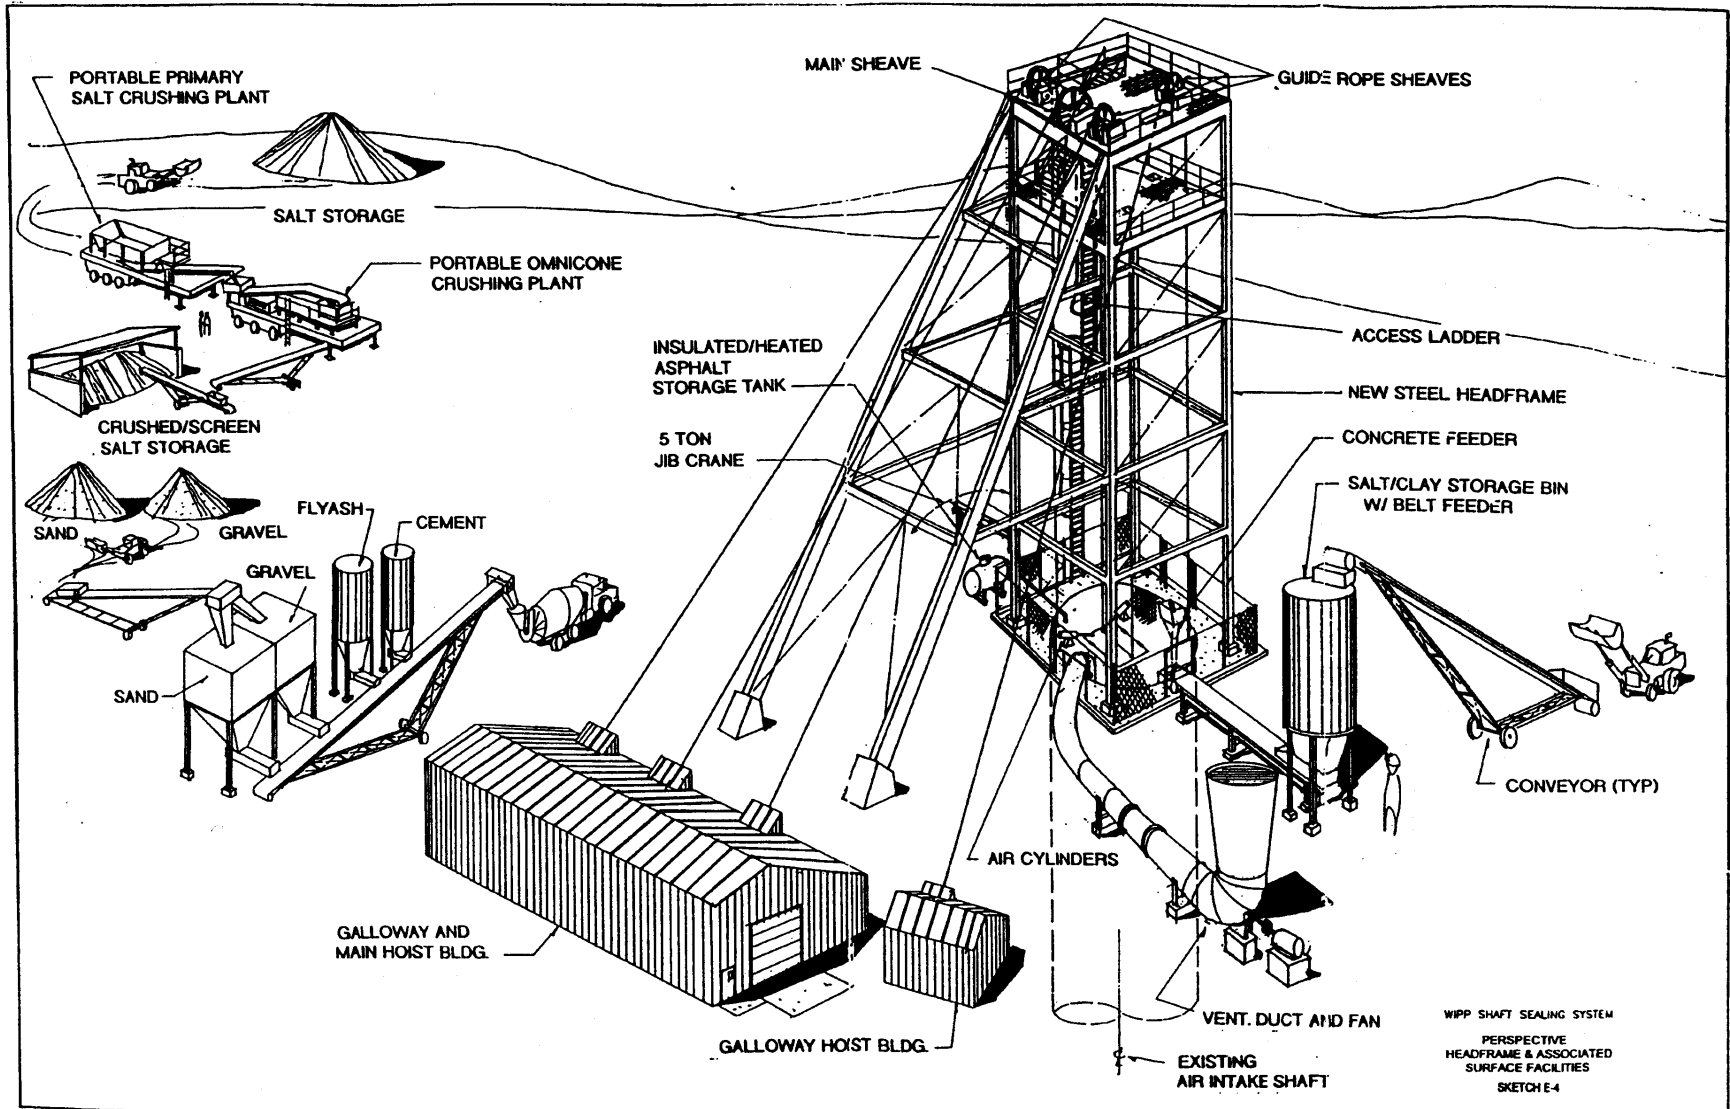

E-36

WIPP Shaft Sealing System Typical Headframe and Associated Surface Facilities

WIPP  
UC721 Distribution List

Federal Agencies

US Department of Energy (4)  
Office of Civilian Radioactive Waste Mgmt.  
Attn: Deputy Director, RW-2  
Acting Director, RW-10  
Office of Human Resources & Admin.  
Director, RW-30  
Office of Program Mgmt. & Integ.  
Director, RW-40  
Office of Waste Accept., Stor., & Tran.  
Forrestal Building  
Washington, DC 20585

Attn: Project Director (2)  
Yucca Mountain Site Characterization Office  
Director, RW-3  
Office of Quality Assurance  
101 Convention Center Drive, Suite #P-110  
Las Vegas, NV 89109

US Department of Energy  
Albuquerque Operations Office  
Attn: National Atomic Museum Library  
P.O. Box 5400  
Albuquerque, NM 87185-5400

US Department of Energy  
Research & Waste Management Division  
Attn: Director  
P.O. Box E  
Oak Ridge, TN 37831

US Department of Energy (8)  
Carlsbad Area Office  
Attn: G. Dials  
D. Galbraith (3)  
M. Matthews  
M. McFadden  
R. Lark  
J. A. Mewhinney  
P.O. Box 3090  
Carlsbad, NM 88221-3090

US Department of Energy  
Office of Environmental Restoration and  
Waste Management  
Attn: J. Lytle, EM-30  
Forrestal Building  
Washington, DC 20585-0002

US Department of Energy (3)  
Office of Environmental Restoration and  
Waste Management  
Attn: M. Frei, EM-34, Trevion II  
Washington, DC 20585-0002

US Department of Energy  
Office of Environmental Restoration and  
Waste Management  
Attn: S. Schneider, EM-342, Trevion II  
Washington, DC 20585-0002

US Department of Energy (2)  
Office of Environment, Safety & Health  
Attn: C. Borgstrom, EH-25  
R. Pelletier, EH-231  
Washington, DC 20585

US Department of Energy (2)  
Idaho Operations Office  
Fuel Processing & Waste Mgmt. Division  
785 DOE Place  
Idaho Falls, ID 83402

US Environmental Protection Agency (2)  
Radiation Protection Programs  
Attn: M. Oge  
ANR-460  
Washington, DC 20460

Boards

Defense Nuclear Facilities Safety Board  
Attn: D. Winters  
625 Indiana Ave. NW, Suite 700  
Washington, DC 20004

Nuclear Waste Technical Review Board (2)  
Attn: Chairman  
S. J. S. Parry  
1100 Wilson Blvd., Suite 910  
Arlington, VA 22209-2297

State Agencies

Attorney General of New Mexico  
P.O. Drawer 1508  
Santa Fe, NM 87504-1508

Environmental Evaluation Group (3)  
Attn: Library  
7007 Wyoming NE, Suite F-2  
Albuquerque, NM 87109

Metropolitan Water District of Southern Calif.  
Attn: J. Narvaiz  
P.O. Box 54153  
Los Angeles, CA 90071-3123

NM Energy, Minerals, and Natural  
Resources Department  
Attn: Library  
2040 S. Pacheco  
Santa Fe, NM 87505

NM Environment Department (3)  
Secretary of the Environment  
Attn: Mark Weidler  
1190 St. Francis Drive  
Santa Fe, NM 87503-0968

NM Bureau of Mines & Mineral Resources  
Socorro, NM 87801

NM Environment Department  
WIPP Project Site  
Attn: P. McCasland  
P.O. Box 3090  
Carlsbad, NM 88221

Laboratories/Corporations

Battelle Pacific Northwest Laboratories (2)  
Attn: R. E. Westerman  
R. Romanc, MS P8-38  
P.O. Box 999  
900 Battelle Blvd.  
Richland, WA 99352

Brookhaven National Laboratory  
Attn: P. D. Moskowitz  
Environmental & Waste Technology  
Center  
Building 830  
Upton, NY 11973

Harnischfeger Corp.  
Phonex Engineering Services  
Attn: R. Luebke  
2969 S. Chase Avenue  
Milwaukee, WI 53207-6408

Ian Clelland  
6656 N. Amdahl Dr.  
Tucson, AZ 85704

INTERA, Inc.  
Attn: G. A. Freeze  
1650 University Blvd. NE, Suite 300  
Albuquerque, NM 87102

INTERA, Inc. (6)  
Attn: J. F. Pickens  
V. Kelley  
M. Reeves  
W. Statham  
J. Beach  
D. Fryar  
INTERA WIPP Library  
6850 Austin Center Blvd., Suite 300  
Austin, TX 78731

INTERA, Inc.  
Attn: J. Lee, YMP PA Dept.  
1261 Town Center Drive  
Las Vegas, NV 89134

INTERA, Inc.  
Attn: W. Stensrud  
P.O. Box 2123  
Carlsbad, NM 88221

Istasca Consulting Group, Inc.  
Attn: John Tinucci  
Thresher Square East  
708 South Third Street, Suite 310  
Minneapolis, MI 55415

Los Alamos National Laboratory  
Attn: B. Erdal, INC-12  
P.O. Box 1663  
Los Alamos, NM 87544

Morton International, Morton Salt  
Attn: H. W. Diamond  
Morton International Building  
100 N. Riverside Plaza,  
Randolph Street at the River  
Chicago, IL 60606-1597

Parsons Brinckerhoff Energy Services, Inc.  
Attn: W. S. Roman  
One Penn Plaza  
New York, NY 10119

Parsons Brinckerhoff Energy Services, Inc. (2)  
Attn: B. W. Lawerance  
C. D. Mann  
M. S. Lin  
303 Second Street  
Suite 850 North  
San Francisco, CA 94107

Waste Isolation Pilot Plant  
Hazardous Waste Permit  
October 27, 1999

Parsons Brinckerhoff International, Inc.  
Attn: Mary Ann Novak  
700 11th Street, NW, Suite 710  
Washington, DC 20001

Phillips Mining, Geotechnical & Grouting  
Attn: Stephen Phillips  
8640 North Glenhurst Place  
Tucson, AZ 85704

RE/SPEC, Inc. (5)  
Attn: L. Van Sambeck (3)  
G. Callahan  
M. Loken  
J. Ratigan  
T. Pfeifle  
3824 Jet Drive  
P.O. Box 725  
Rapid City, SD 57709

RE/SPEC, Inc.  
Attn: Angus Robb  
4775 Indian School NE, Suite 300  
Albuquerque, NM 87110-3927

Science Applications International Corp.  
Attn: W. Thompson  
15000 W. 6th Avenue, Suite 202  
Golden, CO 80401

Tech Keps, Inc. (3)  
Attn: J. Chapman (1)  
L. Robledo (2)  
5000 Marble NE, Suite 222  
Albuquerque, NM 87110

Westinghouse Electric Corporation (5)  
Attn: Library  
J. Epstein  
J. Lee  
B. A. Howard  
R. Kehman  
P.O. Box 2078  
Carlsbad, NM 88221

S. Cohen & Associates  
Attn: Bill Thurber  
1355 Beverly Road  
McLean, VA 22101

National Academy of Sciences,  
WIPP Panel

Howard Adler  
Oxyrase, Incorporated  
7327 Oak Ridge Highway  
Knoxville, TN 37931

Bob Andrews  
Board of Radioactive Waste Management  
GF456  
2101 Constitution Ave.  
Washington, DC 20418

Rodney C. Ewing  
Department of Geology  
University of New Mexico  
Albuquerque, NM 87131

Charles Fairhurst  
Department of Civil  
and Mineral Engineering  
University of Minnesota  
500 Pillsbury Dr. SE  
Minneapolis, MN 55455-0220

B. John Garrick  
PLG Incorporated  
4590 MacArthur Blvd., Suite 400  
Newport Beach, CA 92660-2027

Leonard F. Konikow  
US Geological Survey  
431 National Center  
Reston, VA 22092

Carl A. Anderson, Director  
Board of Radioactive Waste Management  
National Research Council  
HA 456  
2101 Constitution Ave. NW  
Washington, DC 20418

Christopher G. Whipple  
ICF Kaiser Engineers  
1800 Harrison St., 7th Floor  
Oakland, CA 94612-3430

John O. Blomeke  
720 Clubhouse Way  
Knoxville, TN 37909

Sue B. Clark  
University of Georgia  
Savannah River Ecology Lab  
P.O. Drawer E  
Aiken, SC 29802

Konrad B. Krauskopf  
Department of Geology  
Stanford University  
Stanford, CA 94305-2115

Della Roy  
Pennsylvania State University  
217 Materials Research Lab  
Hastings Road  
University Park, PA 16802

David A. Waite  
CH<sub>2</sub> M Hill  
P.O. Box 91500  
Bellevue, WA 98009-2050

Thomas A. Zordon  
Zordon Associates, Inc.  
3807 Edinburg Drive  
Murrysville, PA 15668

Universities

Harvey Mudd College  
Attn: M. Cardenas  
Department of Engineering  
Claremont, CA 91711

New Mexico State University  
Waste-management Education & Research  
Corporation.  
Attn: R. Bhada  
P.O. Box 3001  
Las Cruces, NM 88003-8001

University of California  
Department of Mechanical and Environmental  
Engineering  
Attn: E. Marschall  
University of California  
Santa Barbara, CA 93106

University of Nevada-Reno  
Department of Mining Engineering  
Mackay School of Mines  
Attn: J. Daamen  
Reno, NV 89557

University of New Mexico  
Center for Radioactive Waste Management  
Attn: W. Lutze  
209 Faris Engineering Building  
Albuquerque, NM 87131-1341

University of New Mexico  
Department of Civil Engineering  
Attn: J. C. Stormont  
Albuquerque, NM 87131-1351

University of New Mexico  
Geology Department  
Attn: Library  
141 Northrop Hall  
Albuquerque, NM 87131

University of Washington  
College of Ocean & Fishery Sciences  
Attn: G. R. Heath  
583 Henderson Hall, HN-15  
Seattle, WA 98195

Libraries

Thomas Brannigan Library  
Attn: D. Dresch  
106 W. Hadley St.  
Las Cruces, NM 88001

Government Publications Department  
Zimmerman Library  
University of New Mexico  
Albuquerque, NM 87131

New Mexico Junior College  
Pannell Library  
Attn: R. Hill  
Lovington Highway  
Hobbs, NM 88240

New Mexico State Library  
Attn: N. McCallan  
325 Don Gaspar  
Santa Fe, NM 87503

New Mexico Tech  
Martin Speere Memorial Library  
Campus Street  
Socorro, NM 87810

WIPP Public Reading Room  
Carlsbad Public Library  
101 S. Halagueno St.  
Carlsbad, NM 88220

Foreign Addresses

Atomic Energy Canada Ltd. (5)  
Whiteshell Laboratory  
Attn: Neil Chandler  
Glenn McCrank  
B. Goodwin  
Malcolm Gray  
Maria Onefrei  
Pinawa Manitoba, CANADA ROE 1L0

Distribution - 2

Francois Chenevier (2)  
ANDRA  
Route de Panorama Robert Schumann  
B. P. 38  
92266 Fontenay-aux-Roses, Cedex  
FRANCE

Claude Sombret  
Centre d'Etudes Nucleaires  
de la Vallee Rhone  
CEN/VALRIJO  
S.D.H.A. B.P. 171  
30205 Bagnols-Sur-Ceze, FRANCE

Commissariat a L'Energie Atomique  
Attn: D. Alexandre  
Centre d'Etudes de Cadarache  
13108 Saint Paul Lez Durance Cedex  
FRANCE

Bundesanstalt für Geowissenschaften und  
Kohstoffe (2)  
Attn: M. Langer  
M. Wallner  
Postfach 510 153  
D-30631 Hannover, GERMANY

Bundesministerium für Forschung und  
Technologie  
Postfach 200 706  
5300 Bonn 2, GERMANY

Forschungszentrum Karlsruhe GmbH  
Institut für Nukleare Entsorgungstechnik  
Attn: E. Korthaus  
Postfach 3640, D-76021 Karlsruhe  
Bundesrepublik Deutschland  
GERMANY

Gesellschaft für Anlagen und Reaktorsicherheit  
(GRS)  
Attn: B. Bakes  
Schwertnergasse 1  
D-50667 Cologne, GERMANY

Grundbau Und Felsbau GmbH  
Attn: W. Wittke  
Henricistraße 50  
52072 Aachen, GERMANY

Institut für Gebirgsmechanik  
Attn: W. Minkley  
Friederikenstraße 60  
04279 Leipzig, GERMANY

Institut für Tieflagerung  
Attn: K. Kuhn  
Theodor-Heuss-Strasse 4  
D-3300 Braunschweig, GERMANY  
Shingo Tashiro  
Japan Atomic Energy Research Institute  
Tokai-Mura, Ibaraki-Ken, 319-11  
JAPAN

Netherlands Energy Research Foundation ECN  
Attn: J. Pijl  
3 Westerduinweg  
P.O. Box 1  
1753 ZG Petten  
THE NETHERLANDS

Universiteit Utrecht  
Department of Geology (HPT-lab)  
Attn: C. J. Spiers  
PO Box 80021  
NL-3508 TA Utrecht  
Budapestlaan 4  
THE NETHERLANDS

Svensk Kärnbränsleärsörjning AB  
Attn: F. Karlsson  
Project KBS (Kärnbränslesäkerhet)  
Box 5864  
S-102 48 Stockholm  
SWEDEN

Nationale Genossenschaft für die Lagerung  
Radioaktiver Abfälle (2)  
Attn: S. Vomvoris  
P. Zuidema  
Hardstrasse 73  
CH-5430 Wetingen  
SWITZERLAND

AEA Technology  
Attn: J. H. Rees  
DSW/29 Culham Laboratory  
Abington, Oxfordshire OX14 3DB  
UNITED KINGDOM

AEA Technology  
Attn: W. R. Rodwell  
044/A31 Winfrith Technical Centre  
Dorchester, Dorset DT2 8DH  
UNITED KINGDOM

AEA Technology  
Attn: J. E. Tinson  
B4244 Harwell Laboratory  
Didcot, Oxfordshire OX11 0RA  
UNITED KINGDOM

# Internal

MS	Org.	
0483	5165	R. E. Stinebaugh
0706	6113	J. K. Linn
1320	6719	E. J. Nowak
1322	6121	J. R. Tillerson (10)
1322	6121	E. H. Ahrens (2)
1322	6121	A. W. Dennis (10)
1322	6121	F. D. Hansen
1322	6121	L. D. Hurtado
1322	6121	M. K. Knowles
1324	6115	P. B. Davies
1325	6852	L. S. Costin
1325	6852	R. E. Finley
1328	6749	D. R. Anderson
1328	6741	H. N. Jow
1328	6849	M. F. Fewell
1328	6849	P. Vaughn
1335	6705	M. Chu
1341	6748	J. T. Holmes
1395	6800	L. Shephard
1395	6707	M. Marietta
1395	6841	V. H. Slaboszewicz
1330	6752	B. J. Pierson (2)
1330	6752	NWM Library (100)
9018	8523-2	Central Technical Files
0899	4414	Technical Library (5)
0619	12630	Review and Approval Desk, For DOE/OSTI (2)

SAND96-1326/2  
Unlimited Release  
Printed August 1996

Distribution  
Category UC-721

**Waste Isolation Pilot Plant  
Shaft Sealing System  
Compliance Submittal Design Report**

**Volume 2 of 2:  
Appendix E**

Repository Isolation Systems Department  
Sandia National Laboratories  
Albuquerque, NM 87185

**ABSTRACT**

This is the second volume of a two-volume report describing a shaft sealing system design for the Waste Isolation Pilot Plant. This appendix contains detailed drawings of the shaft sealing system and its components.